

SURVEY & REMONUMENTATION

JAN 20 1995 UT 1257

LIBER 15213 PG 105

MAY - 1 1995

LAND CORNER RECORDATION CERTIFICATE

Filing Requirement of Act 74, Mich. P.A. 1970

OK - T. SMITH

93-1010

For corners in

COMMISSION

Oakland

(County)

Located In: Oakland Corner Code ##

- 1. Public Land Survey T 4N R 11E I-6  
T \_\_\_\_\_ R \_\_\_\_\_  
T \_\_\_\_\_ R \_\_\_\_\_  
T \_\_\_\_\_ R \_\_\_\_\_
- 2. Property Controlling S \_\_\_\_\_ T \_\_\_\_\_ R \_\_\_\_\_  
in Section S \_\_\_\_\_ T \_\_\_\_\_ R \_\_\_\_\_
- 3. Miscellaneous S \_\_\_\_\_ T \_\_\_\_\_ R \_\_\_\_\_  
Property in Sec. S \_\_\_\_\_ T \_\_\_\_\_ R \_\_\_\_\_

\$ 9.00 MISCELLANEOUS RECORDING  
\$ 2.00 REMONUMENTATION  
20 JAN 95 8:07 A.M. RECEIPT# 128  
PAID RECORDED - OAKLAND COUNTY  
LYNN D. ALLEN, CLERK/REGISTER OF DEEDS

Compliance with  
ACT 345, P.A. 1990

APPROVED ON: 01-26-94  
OAKLAND COUNTY REMONUMENTATION  
PEER GROUP COMMITTEE  
Register of Deeds Stamp & File Number

- 4. Lot No. \_\_\_\_\_, Recorded Plat \_\_\_\_\_
- 5. Private Claims \_\_\_\_\_

Grant J. Ward, RLS, in a field survey on December 8, 19 93, do hereby certify that under requirements of P.A. 74, Michigan P.A. of 1970, the corner points mentioned in lines 1 and 2 above were in conformance with regulations and rules therefore as required in the current manual of survey instructions of the United States Department of the Interior, Bureau of Land Management or by a decree of a Court of Law and/or that the corner points mentioned in lines 3, 4 and 5 above were in conformance with the rules of the Michigan Board of Land Surveyors or by a Decree of a Court of Law; established, re-established, monumented, re-monumented, recovered, found as expressed below:

	A	B	C	D	E	F	G	H	I	J	K	L
2	6	5	4	3	2	1						
3												
4	7	8	9	10	11	12						
5												
6	18	17	16	15	14	13						
7												
8	19	20	21	22	23	24						
9												
10	30	29	28	27	26	25						
11												
12	31	32	33	34	35	36						

**NOTE: Not more than 4 corners, all in the same town and range, may be recorded on this certificate.**

A. Description of original monument and accessories and/or subsequent restoration:

I-6 Post, per G.L.O. Notes.

B. Description of corner evidence found and/or method applied in restoring or reestablishing corner:


I-6 Corner common to Sec. 14 and 15, T. 4 N., R. 11 E. Found P.K. Nail in the Northbound lane of Rochester Road, 6' East of the Centerline. Tree line to the East. This corner location is a careful and faithful perpetuation of the position of the original corner.

Previously Unrecorded in Oakland County Records.

C. Description of monument for corner and accessories established to perpetuate locating the position of the corner:

I-6 Corner common to Sec. 14 and 15, T. 4 N., R. 11 E. Set Iron Rod and Brass Cap #22445 in Monument Box.

- S. 55° E. 25.71' Set P.K. Nail & Brass Disc #22445 in S. face of 6" Elm.
- S. 81° E. 37.07' Set P.K. Nail & Brass Disc #22445 in N. face of 12" Elm.
- N. 56° E. 56.32' Set P.K. Nail & Brass Disc #22445 in SE. face of 4" Elm.
- N. 23° W. 78.77' Set P.K. Nail & Brass Disc #22445 in NE. face of Utility Pole.
- S. 89° E. 48.51' Found Monument.

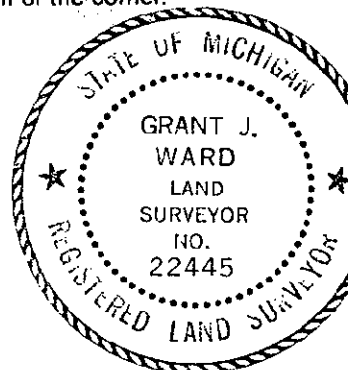

Signed by [Signature]

Date December 15, 1994

Surveyor's Michigan License No. 22445

93-1010