

**SURVEY &
REMONUMENTATION**

LIBER **15095** PC **038**

Nov 15 94 2 95 3 90

Compliance with
ACT 345, P.A. 1990

APPROVED ON: 12-22-93

LAND CORNER RECORDATION CERTIFICATE

Filing Requirement of Act 74, Mich. P.A. 1970

93-1010 **MAY - 1 1995**

For corners in

Oakland
(County)

COMMISSION

Located In: Oakland Corner Code #

OAKLAND COUNTY REMONUMENTATION
PEER GROUP COMMITTEE

\$ 9.00 MISCELLANEOUS RECORDING
\$ 2.00 REMONUMENTATION
15 NOV 94 9:00 A.M. RECEIPT# 14B
PAID RECORDED - OAKLAND COUNTY
LYNN D. ALLEN, CLERK/REGISTER OF DEEDS

OK - T. SMITH

Register of Deeds Stamp & File Number

1. Public Land Survey	T	<u>4N</u>	R	<u>11E</u>	<u>I-7</u>
	T		R		
	T		R		
	T		R		
2. Property Controlling in Section	S		T	R	
	S		T	R	
3. Miscellaneous Property in Sec.	S		T	R	
	S		T	R	

4. Lot No. _____, Recorded Plat _____
5. Private Claims _____

A	B	C	D	E	F	G	H	I	J	K	L
2	6	5	4	3	2						
3											
4	7	8	9	10	11	12					
5											
6	18	17	16	15	14	13					
7											
8	19	20	21	22	23	24					
9											
10	30	29	28	27	26	25					
11											
12	31	32	33	34	35	36					
13											

I, Grant J. Ward, RLS, in a field survey on October 19, 19 93, do hereby certify that under requirements of P.A. 74, Michigan P.A. of 1970, the corner points mentioned in lines 1 and 2 above were in conformance with regulations and rules therefore as required in the current manual of survey instructions of the United States Department of the Interior, Bureau of Land Management or by a decree of a Court of Law and/or that the corner points mentioned in lines 3, 4 and 5 above were in conformance with the rules of the Michigan Board of Land Surveyors or by a Decree of a Court of Law; established, re-established, monumented, re-monumented, recovered, found as expressed below:

NOTE: Not more than 4 corners, all in the same town and range, may be recorded on this certificate.

A. Description of original monument and accessories and/or subsequent restoration:

I-7 Post, per G.L.O. Notes.

B. Description of corner evidence found and/or method applied in restoring or reestablishing corner:

I-7 Corner common to Sec. 14, 15, 22 & 23, T. 4 N., R. 11 E. Found 1" Boat Spike in Monument Box in Centerline of Buell Road and 1' West of Centerline of Rochester Road. Set Iron Rod and Brass Cap #22445, adjoining Found Boat Spike, in Monument Box. This corner has been accepted by the peer group established under Act 345 of P.A. 1990 and is a careful and faithful perpetuation of the position of the original corner.


Previously Recorded in L. 6260, P. 662 (0); L. 6877, P. 555 (0); L. 6965, P. 91 (1); L. 10324, P. 469 (2); L. 10341, P. 882 (2); and L. 10855, P. 813 (2) of Oakland County Records.

(n) Indicates the number of references that confirm this corner by dimensional tie.

C. Description of monument for corner and accessories established to perpetuate locating the position of the corner:

I-7 Corner common to Sec. 14, 15, 22 & 23, T. 4 N., R. 11 E. Set Iron Rod and Brass Cap #22445 in Monument Box in Centerline of Buell Road and 1' West of Centerline of Rochester Road.

- N. 42° W. 44.64' Found Form Nail and Washer #17623 in S.W. face of Power Pole.
- S. 50° W. 55.40' Found Form Nail and Washer #17623 in S.E. face of Power Pole.
- N. 41° E. 57.46' Found Nail and Disc RCOC in W. face of 8" Ash.
- S. 59° W. 65.78' Found P.K. Nail in S.E. face of 12" twin Ash.

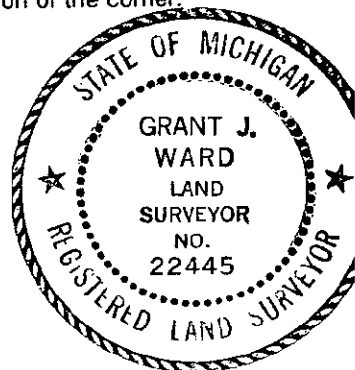

Signed by [Signature]
Surveyor's Michigan License No. 22445

Date November 3, 1994