

MAY - 1 1995

OK - T. SMITH

93-1010 COMMISSION

LAND CORNER RECORDATION CERTIFICATE
Filing Requirement of Act 74, Mich. P.A. 1970

9.00 MISCELLANEOUS RECORDING
2.00 REMONUMENTATION
20 JAN 95 8:08 A.M. RECEIPT# 12B
PAID RECORDED - OAKLAND COUNTY
LYNN D. ALLEN, CLERK/REGISTER OF DEEDS

Oakland (County)

Located in: Oakland Corner Code #

- 1. Public Land Survey T 4N R 11E I-10
2. Property Controlling in Section S T R
3. Miscellaneous Property in Sec. S T R

Compliance with ACT 345, P.A. 1990

APPROVED ON: 12-07-94
OAKLAND COUNTY REMONUMENTATION PEER GROUP COMMITTEE
Register of Deeds Stamp & File Number

- 4. Lot No. Recorded Plat
5. Private Claims

Grid table with columns A-L and rows 1-13. A dot is marked at the intersection of column G and row 10.

I, Grant J. Ward, RLS, in a field survey on December 28, 1993, do hereby certify that under requirements of P.A. 74, Michigan P.A. of 1970, the corner points mentioned in lines 1 and 2 above were in conformance with regulations and rules therefore as required in the current manual of survey instructions of the United States Department of the Interior, Bureau of Land Management or by a decree of a Court of Law and/or that the corner points mentioned in lines 3, 4 and 5 above were in conformance with the rules of the Michigan Board of Land Surveyors or by a Decree of a Court of Law; established, re-established, monumented, re-monumented, recovered, found as expressed below:

NOTE: Not more than 4 corners, all in the same town and range, may be recorded on this certificate.

A. Description of original monument and accessories and/or subsequent restoration:

I-10 Post, per G.L.O. Notes.

Handwritten signature/initials.

B. Description of corner evidence found and/or method applied in restoring or reestablishing corner:

I-10 Corner common to Sec. 26 and 27, T. 4 N., R. 11 E. Found Boat Spike in Monument Box, 0.5' East of the Centerline of Rochester Road, 0.35' below Road surface, at the intersection of Rochester and Snell Roads. Corner is in the Centerline of Snell Road. This corner location is a careful and faithful perpetuation of the position of the original corner.


Previously Recorded in L. 5961, P. 591 (1); L. 6165, P. 157 (1); L. 6504, P. 680 (0); L. 7618, P. 839 (1); and L. 10010, P. 616 (2) of Oakland County Records.

(n) Indicates the number of references that confirms this corner by dimensional tie.

C. Description of monument for corner and accessories established to perpetuate locating the position of the corner:

I-10 Corner common to Sec. 27 and 28, T. 4 N., R. 11 E. Set Iron Rod and Brass Cap #22445 in Found Monument Box.

- N. 20° W. 65.27' Set P.K. Nail & Brass Disc #22445 in NE. face of 10" Elm.
N. 70° E. 62.77' Set P.K. Nail & Brass Disc #22445 in NW. face of Utility Pole.
S. 30° E. 59.20' Chiseled "+" in NW. rim of Storm Manhole.
S. 30° W. 74.98' Set P.K. Nail & Brass Disc #22445 in E. face of Utility Pole.

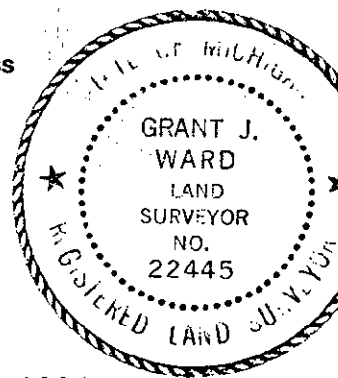

Signed by [Signature]
Surveyor's Michigan License No. 22445

Date December 15, 1994