

SURVEY &
REMONUMENTATION

LIBER 15095 PG 044

Nov 15 94 295393

93-1010 MAY - 1 1995 LAND CORNER RECORDATION CERTIFICATE
For corners in COMMISSION Filing Requirement of Act 74, Mich. P.A. 1970
Oakland (County) Located In: Oakland Corner Code #

OK - T. SMITH

- | | | | | | |
|------------------------------------|---|----|---|-----|-----|
| 1. Public Land Survey | T | 4N | R | 11E | J-1 |
| | T | | R | | |
| | T | | R | | |
| | T | | R | | |
| 2. Property Controlling in Section | S | | T | R | |
| | S | | T | R | |
| 3. Miscellaneous Property in Sec. | S | | T | R | |
| | S | | T | R | |

\$ 9.00 MISCELLANEOUS RECORDING
\$ 2.00 REMONUMENTATION
15 NOV 94 9:00 A.M. RECEIPT# 148
PAID RECORDED - OAKLAND COUNTY
LYNN D. ALLEN CLERK REGISTER OF DEEDS
ACT 345, P.A. 1990

APPROVED ON: 12-22-93
OAKLAND COUNTY REMONUMENTATION
PEER GROUP COMMITTEE

Register of Deeds Stamp & File Number

4. Lot No. _____, Recorded Plat _____
5. Private Claims _____

	A	B	C	D	E	F	G	H	I	J	K	L
2	6		5		4		3		2		1	
3												
4	7		8		9		10		11		12	
5												
6	18		17		16		15		14		13	
7												
8	19		20		21		22		23		24	
9												
10	30		29		28		27		26		25	
11												
12	31		32		33		34		35		36	
13												

I, Grant J. Ward, RLS, in a field survey on November 3, 1993, do hereby certify that under requirements of P.A. 74, Michigan P.A. of 1970, the corner points mentioned in lines 1 and 2 above were in conformance with regulations and rules therefore as required in the current manual of survey instructions of the United States Department of the Interior, Bureau of Land Management or by a decree of a Court of Law and/or that the corner points mentioned in lines 3, 4 and 5 above were in conformance with the rules of the Michigan Board of Land Surveyors or by a Decree of a Court of Law; established, re-established, monumented, re-monumented, recovered, found as expressed below:

NOTE: Not more than 4 corners, all in the same town and range, may be recorded on this certificate.

A. Description of original monument and accessories and/or subsequent restoration:

J-1 None, not set according to G.L.O. Notes.

Handwritten signature/initials

B. Description of corner evidence found and/or method applied in restoring or reestablishing corner:

J-1 Corner common to Sec. 2 & Town Line, T. 4 N., R. 11 E. Found Iron Rod 1/2" in Monument Box, 1.00' North of Centerline of Romeo Road. Pine row to South. Set Iron Rod and Brass Cap #22445, adjoining Found Iron Rod, in Monument Box. This corner has been accepted by the peer group established under Act 345 of P.A. 1990 and although not established by an original government survey, is accepted as the best available evidence of the position of the corner.


Previously Recorded in L. 6965, P. 89 (2); and L. 12273, P. 477 (5) of Oakland County Records.

(n) Indicates the number of references that confirm this corner by dimensional tie.

C. Description of monument for corner and accessories established to perpetuate locating the position of the corner:

J-1 Corner common to Sec. 2 & Town Line, T. 4 N., R. 11 E. Set Iron Rod and Brass Cap #22445 in Monument Box, 1.00' North of Centerline of Romeo Road. Pine row to South.

- S. 66° E. 87.88' Set P.K. Nail and Disc #22445 in S.W. face of 36" Maple.
- S. 08° E. 35.20' Set P.K. Nail and Disc #22445 in W. face of 12" Pine.
- N. 10° E. 40.38' Set P.K. Nail and Disc #22445 in E. face of Utility Pole.
- N. 89° E. 8.34' Found Iron Rod 1/2" in Asphalt.
- S. 02° E. 32.94' Found Iron Pipe.

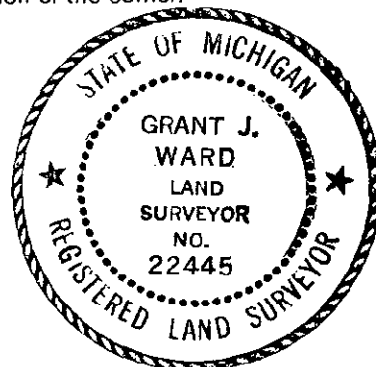

Signed by [Signature] Date November 3, 1994
Surveyor's Michigan License No. 22445