

**SURVEY &
REMONUMENTATION**

LISEP **15213** PG **119**

JAN 20 95 011264

MAY - 1 1995

OK - T. SMITH

LAND CORNER RECORDATION CERTIFICATE

93-1010
For corners in

COMMISSION

Filing Requirement of Act 74, Mich. P.A. 1970 9.00

MISCELLANEOUS RECORDING

Oakland
(County)

Located In: Oakland Corner Code J-9

\$ 2.00 REMONUMENTATION
20 JAN 95 8:08 A.M. RECEIPT# 128
PAID RECORDED - OAKLAND COUNTY
LYNN D. ALLEN, CLERK/REGISTER OF DEEDS

Compliance with
ACT 345, P.A. 1990

APPROVED ON: 01-26-94
OAKLAND COUNTY REMONUMENTATION
PEER GROUP COMMITTEE
Register of Deeds Stamp & File Number

- 1. Public Land Survey T 4N R 11E J-9
- T _____ R _____
- T _____ R _____
- T _____ R _____
- 2. Property Controlling S _____ T _____ R _____
- in Section S _____ T _____ R _____
- 3. Miscellaneous S _____ T _____ R _____
- Property in Sec. S _____ T _____ R _____
- 4. Lot No. _____, Recorded Plat _____
- 5. Private Claims _____

	A	B	C	D	E	F	G	H	I	J	K	L	N
2	6	5	4	3	2	1							
3													
4	7	8	9	10	11	12							
5													
6	18	17	16	15	14	13							
7													
8	19	20	21	22	23	24							
9													
10	30	29	28	27	26	25							
11													
12	31	32	33	34	35	36							
13													

I, Grant J. Ward, RLS, in a field survey on October 18, 19 93, do hereby certify that under requirements of P.A. 74, Michigan P.A. of 1970, the corner points mentioned in lines 1 and 2 above were in conformance with regulations and rules therefore as required in the current manual of survey instructions of the United States Department of the Interior, Bureau of Land Management or by a decree of a Court of Law and/or that the corner points mentioned in lines 3, 4 and 5 above were in conformance with the rules of the Michigan Board of Land Surveyors or by a Decree of a Court of Law; established, re-established, monumented, re-monumented, recovered, found as expressed below:

NOTE: Not more than 4 corners, all in the same town and range, may be recorded on this certificate.

A. Description of original monument and accessories and/or subsequent restoration:

J-9 Post, per G.L.O. Notes.

B. Description of corner evidence found and/or method applied in restoring or reestablishing corner:

J-9 Corner common to Sec. 23 and 26, T. 4 N., R. 11 E. Found Iron Rod and Cap #21563 in a 3 way intersection 4' South of the Centerline of Gunn Road and in the Centerline of Sheldon Road. P.K. Nail found 0.07' Due South. This corner location is a careful and faithful perpetuation of the position of the original corner.


Previously Recorded in L. 7009, P. 703 (2); L. 7618, P. 839 (0); L. 7960, P. 386 (0); L. 11082, P. 231 (4); and L. 11792, P. 227 (4) of Oakland County Records.

(n) Indicates the number of references that confirm this corner by dimensional tie.

C. Description of monument for corner and accessories established to perpetuate locating the position of the corner:

J-9 Corner common to Sec. 23 and 26, T. 4 N., R. 11 E. Set Concrete Monument Box and 5/8" Iron Rod and Brass Cap #22445.

- N. 55° E. 37.44' Set P.K. Nail & Brass Disc #22445 in S. face of 18" Oak.
- S. 52° E. 51.86' Set P.K. Nail & Brass Disc #22445 in N. face of 10" Ash.
- S. 75° W. 61.81' Set P.K. Nail & Brass Disc #22445 in N. face of twin 14" Ash.
- N. 42° W. 44.47' Set P.K. Nail & Brass Disc #22445 in SW. face of Michigan Bell Telephone Pole.

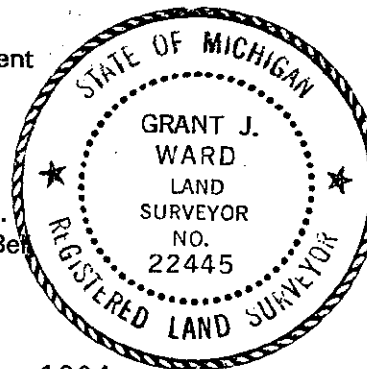

Signed by [Signature]
Surveyor's Michigan License No. 22445

Date December 15, 1994