

SURVEY & REMONUMENTATION

LIBER **15213** PG **123**

JAN 20 95 011266

OK - T. SMITH

MAY - 1 1995

LAND CORNER RECORDATION CERTIFICATE

93-1010
For corners in

COMMISSION

Filing Requirement of Act 74, Mich. P.A. 1970

9.00 MISCELLANEOUS RECORDING
2.00 REMONUMENTATION

Oakland
(County)

Located In: Oakland Corner Code #

20 JAN 95 8:08 A.M. RECEIPT# 12B
PAID RECORDED - OAKLAND COUNTY
LYNN D. ALLEN, CLERK/REGISTER OF DEEDS

- 1. Public Land Survey T 4N R 11E K-1
T _____ R _____
T _____ R _____
T _____ R _____
- 2. Property Controlling S _____ T _____ R _____
in Section S _____ T _____ R _____
- 3. Miscellaneous S _____ T _____ R _____
Property in Sec. S _____ T _____ R _____

Compliance with
ACT 345, P.A. 1990

APPROVED ON: 02-09-94
OAKLAND COUNTY REMONUMENTATION
PEER GROUP COMMITTEE
Register of Deeds Stamp & File Number

- 4. Lot No. _____, Recorded Plat _____
- 5. Private Claims _____

I, Grant J. Ward, RLS, in a field survey on November 3, 19 93, do hereby certify that under requirements of P.A. 74, Michigan P.A. of 1970, the corner points mentioned in lines 1 and 2 above were in conformance with regulations and rules therefore as required in the current manual of survey instructions of the United States Department of the Interior, Bureau of Land Management or by a decree of a Court of Law and/or that the corner points mentioned in lines 3, 4 and 5 above were in conformance with the rules of the Michigan Board of Land Surveyors or by a Decree of a Court of Law; established, re-established, monumented, re-monumented, recovered, found as expressed below:

	A	B	C	D	E	F	G	H	I	J	K	L	I
2	6		5		4		3		2		1		
3													
4	7		8		9		10		11		12		
5													
6	18		17		16		15		14		13		
7													
8	19		20		21		22		23		24		
9													
10	30		29		28		27		26		25		
11													
12	31		32		33		34		35		36		
13													

NOTE: Not more than 4 corners, all in the same town and range, may be recorded on this certificate.

A. Description of original monument and accessories and/or subsequent restoration:

K-1 Post, per G.L.O. Notes.

B. Description of corner evidence found and/or method applied in restoring or reestablishing corner:

K-1 Corner common to Sec. 1, 2 and Town Line, T. 4 N., R. 11 E. Found 1/2" Iron Rod, 10.5' North of the Centerline of Romeo Road, 0.25' below the asphalt at the intersections of Romeo and Townsend Roads. This corner location is a careful and faithful perpetuation of the position of the original corner.


Previously Recorded in L. 6384, P. 801 (listed incorrectly as K-2 in Line 1) (1); L. 6965, P. 89 (3); L. 9673, P. 254 (3); and L. 12273, P. 477 (4) of Oakland County Records.

(n) Indicates the number of references that confirm this corner by dimensional tie.

C. Description of monument for corner and accessories established to perpetuate locating the position of the corner:

K-1 Corner common to Sec. 1, 2 and Town Line, T. 4 N., R. 11 E. Set Concrete Monument Box and 5/8" Iron Rod and Brass Cap #22445.

- S. 24° W. 44.99' Set P.K. Nail & Brass Disc #22445 in NW. face of twin 12" Ash.
- N. 27° W. 25.33' Set P.K. Nail & Brass Disc #22445 in SW. face of Fence Post.
- N. 48° E. 49.39' Set P.K. Nail & Brass Disc #22445 in SE. face of Utility Pole.
- S. 46° E. 73.91' Set P.K. Nail & Brass Disc #22445 in NE. face of 14" Walnut.

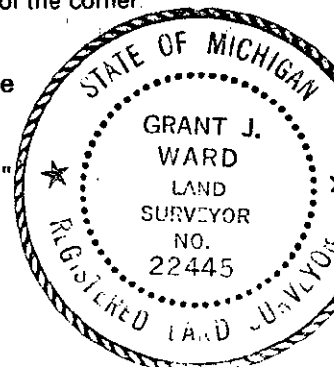

Signed by [Signature]
Surveyor's Michigan License No. 22445

Date December 15, 1994

93-1010