

**SURVEY &
REMONUMENTATION**

Land/cor

MAY - 1 1995

LIBER 15213 PG. 125

JAN 20 95 011267

COMMISSION LAND CORNER RECORDATION CERTIFICATE

OK - T. SMITH

Filing Requirement of Act 74, Mich. P.A. 1970

93-1010

For corners in

Oakland

(County)

Located In: Oakland Corner Code #

- | | | | | | |
|------------------------------------|---|------------|---|-------------|------------|
| 1. Public Land Survey | T | <u>4</u> N | R | <u>11</u> E | <u>K-2</u> |
| | T | | R | | |
| | T | | R | | |
| | T | | R | | |
| 2. Property Controlling in Section | S | | T | R | |
| | S | | T | R | |
| 3. Miscellaneous Property in Sec. | S | | T | R | |
| | S | | T | R | |

\$ 9.00 MISCELLANEOUS RECORDING

\$ 2.00 REMONUMENTATION

20 JAN 95 8:09 A.M. RECEIPT# 12B

PAID RECORDED - OAKLAND COUNTY

LYNN D. ALLEN, CLERK/REGISTER OF DEEDS

Compliance with
ACT 345, P.A. 1990

APPROVED ON: 12-19-94
OAKLAND COUNTY REMONUMENTATION
PEER GROUP COMMITTEE
Register of Deeds Stamp & File Number

4. Lot No. _____, Recorded Plat _____
5. Private Claims _____

A	B	C	D	E	F	G	H	I	J	K	L
2	6	5	4	3	2	1					
3											
4	7	8	9	10	11	12					
5											
6	18	17	16	15	14	13					
7											
8	19	20	21	22	23	24					
9											
10	30	29	28	27	26	25					
11											
12	31	32	33	34	35	36					
13											

I, Grant J. Ward, RLS in a field survey on February 10, 1994, do hereby certify that under requirements of P.A. 74, Michigan P.A. of 1970, the corner points mentioned in lines 1 and 2 above were in conformance with regulations and rules therefore as required in the current manual of survey instructions of the United States Department of the Interior, Bureau of Land Management or by a decree of a Court of Law and/or that the corner points mentioned in lines 3, 4 and 5 above were in conformance with the rules of the Michigan Board of Land Surveyors or by a Decree of a Court of Law; established, re-established, monumented, re-monumented, recovered, found as expressed below:

NOTE: Not more than 4 corners, all in the same town and range, may be recorded on this certificate.

A. Description of original monument and accessories and/or subsequent restoration:

K-2 Post, per G.L.O. Notes.

B. Description of corner evidence found and/or method applied in restoring or reestablishing corner:

K-2 Corner common to Sec. 1, and 2, T. 4 N., R. 11 E. Found 1/2" Iron Rod on the North edge of a shallow stream running East and West. Fence runs North, South, East and West. Tree line runs South. This corner location is a careful and faithful re-establishment of the position of the original corner.

Previously Recorded in L. 6384, P. 801 (this corner is listed as K-2, but is actually K-1)(O) and L. 6393, P. 58 (NA) of Oakland County Records.


(n) Indicates the number of references that confirm this corner by dimensional tie.

(NA) Not Accepted

C. Description of monument for corner and accessories established to perpetuate locating the position of the corner:

K-2 Corner common to Sec. 1, and 2, T. 4 N., R. 11 E. Set 5' Iron Rod and Brass Cap #22445 adjoining Found 1/2" Iron Rod.

- | | | |
|-----------|--------|---|
| Due North | 2.30' | Found Nail & Disc #17623 in W. face of 36" Stump. |
| S. 35° W. | 48.38' | Set P.K. Nail & Brass Disc #22445 in NW. face of 12" Ash. |
| Due West | 26.06' | Set P.K. Nail & Brass Disc #22445 in N. face of 12" Oak. |
| N. 75° E. | 4.38' | Set P.K. Nail & Brass Disc #22445 in S. face of 8" Elm. |
| S. 41° E. | 50.84' | Found Iron Rod. |

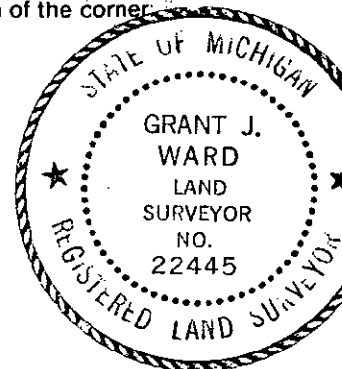

Signed by

Grant J. Ward

Date December 30, 1994

Surveyor's Michigan License No. 22445