

**SURVEY &
REMONUMENTATION**

LIBER **15095** PC **052**

Nov 15 94 295397

93-1010
For corners in
Oakland
(County)
COMMISSION

MAY - 1 1995

LAND CORNER RECORDATION CERTIFICATE
Filing Requirement of Act 74, Mich. P.A. 1970

Compliance with
ACT 345, P.A. 1990

APPROVED ON: 12-19-94
OAKLAND COUNTY REMONUMENTATION
PEER GROUP COMMITTEE

\$ 9.00 MISCELLANEOUS RECORDING
\$ 2.00 REMONUMENTATION
15 NOV 94 9:01 A.M. RECEIPT# 14B
PAID RECORDED - OAKLAND COUNTY
LYNN D. ALLEN, CLERK/REGISTER OF DEEDS

OK - T. SMITH

Register of Deeds Stamp & File Number

Located In: Oakland Corner Code ##

1. Public Land Survey	T	<u>4N</u>	R	<u>11E</u>	<u>K-3</u>
	T		R		
	T		R		
	T		R		
2. Property Controlling in Section	S		T		R
	S		T		R
3. Miscellaneous Property in Sec.	S		T		R
	S		T		R

4. Lot No. _____, Recorded Plat _____
5. Private Claims _____

I, Grant J. Ward, RLS, in a field survey on October 26, 19 93, do hereby certify that under requirements of P.A. 74, Michigan P.A. of 1970, the corner points mentioned in lines 1 and 2 above were in conformance with regulations and rules therefore as required in the current manual of survey instructions of the United States Department of the Interior, Bureau of Land Management or by a decree of a Court of Law and/or that the corner points mentioned in lines 3, 4 and 5 above were in conformance with the rules of the Michigan Board of Land Surveyors or by a Decree of a Court of Law; established, re-established, monumented, re-monumented, recovered, found as expressed below:

NOTE: Not more than 4 corners, all in the same town and range, may be recorded on this certificate.

A. Description of original monument and accessories and/or subsequent restoration:

K-3 Post, per G.L.O. Notes.

B. Description of corner evidence found and/or method applied in restoring or reestablishing corner:

K-3 Corner common to Sec. 1, 2, 11 & 12, T. 4 N., R. 11 E. Found Iron Rod 5/8", 0.35' below Road surface, 4' West of Centerline of Rush Road and 2.5' North of Centerline of Predmore Road. Fence and tree line to North. Set Iron Rod and Brass Cap #22445, adjoining Found Iron Rod. This corner has been accepted by the peer group established under Act 345 of P.A. 1990 and is a careful and faithful perpetuation of the position of the original corner.


Previously Recorded in L. 5892, P. 265 (2); L. 6393, P. 58 (3); and L. 7354, P. 684 (3) of Oakland County Records.

(n) Indicates the number of references that confirm this corner by dimensional tie.

C. Description of monument for corner and accessories established to perpetuate locating the position of the corner:

K-3 Corner common to Sec. 1, 2, 11 & 12, T. 4 N., R. 11 E. Set Iron Rod and Brass Cap #22445, 0.35' below Road surface, 4' West of Centerline of Rush Road and 2.5' North of Centerline of Predmore Road. Fence and tree line to North.

N. 60° E. 39.54' Set P.K. Nail and Disc #22445 in S.E. face of 14" Ash.
S. 68° E. 69.62' Set 60d Nail and Disc #22445 in N. face of 18" Cherry.
S. 79° W. 69.51' Set P.K. Nail and Disc #22445 in N. face of twin 14" Oak.
N. 60° W. 42.34' Set P.K. Nail and Disc #22445 in S. face of 6" Ash.

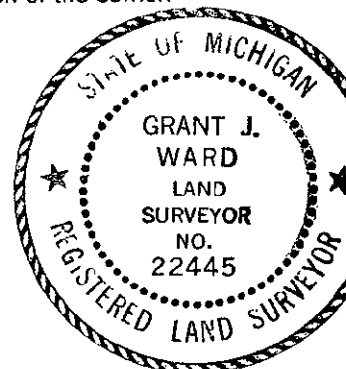

Signed by [Signature]
Surveyor's Michigan License No. 22445

Date November 3, 1994