

SURVEY &  
REMONUMENTATION

LIBER 15095 P. 056

Nov 15 94 295399

Compliance with  
ACT 345, P.A. 1990

MAY - 1 1995

LAND CORNER RECORDATION CERTIFICATE

APPROVED ON: 12-22-93

93-1010

For corners in

COMMISSION

Filing Requirement of Act 74, Mich. P.A. 1970

OAKLAND COUNTY REMONUMENTATION  
PEER GROUP COMMITTEE

Oakland  
(County)

Located In: Oakland Corner Code #

\$ 9.00 MISCELLANEOUS RECORDING  
\$ 2.00 REMONUMENTATION  
15 NOV 94 9:01 A.M. RECEIPT# 14B  
PAID RECORDED - OAKLAND COUNTY  
LYNN D. ALLEN, CLERK/REGISTER OF DEEDS

- |                                       |   |    |   |     |     |
|---------------------------------------|---|----|---|-----|-----|
| 1. Public Land Survey                 | T | 4N | R | 11E | K-5 |
|                                       | T |    | R |     |     |
|                                       | T |    | R |     |     |
|                                       | T |    | R |     |     |
| 2. Property Controlling<br>in Section | S |    | T | R   |     |
|                                       | S |    | T | R   |     |
| 3. Miscellaneous<br>Property in Sec.  | S |    | T | R   |     |
|                                       | S |    | T | R   |     |

OK - T. SMITH  
Register of Deeds Stamp & File Number

4. Lot No. \_\_\_\_\_, Recorded Plat \_\_\_\_\_  
5. Private Claims \_\_\_\_\_

	A	B	C	D	E	F	G	H	I	J	K	L
2	6	5	4	3	2	1						
3												
4	7	8	9	10	11	12						
5												
6	18	17	16	15	14	13						
7												
8	19	20	21	22	23	24						
9												
10	30	29	28	27	26	25						
11												
12	31	32	33	34	35	36						

I, Grant J. Ward, RLS, in a field survey on October 21, 19 93, do hereby certify that under requirements of P.A. 74, Michigan P.A. of 1970, the corner points mentioned in lines 1 and 2 above were in conformance with regulations and rules therefore as required in the current manual of survey instructions of the United States Department of the Interior, Bureau of Land Management or by a decree of a Court of Law and/or that the corner points mentioned in lines 3, 4 and 5 above were in conformance with the rules of the Michigan Board of Land Surveyors or by a Decree of a Court of Law, established, re-established, monumented, re-monumented, recovered, found as expressed below:

**NOTE: Not more than 4 corners, all in the same town and range, may be recorded on this certificate.**

A. Description of original monument and accessories and/or subsequent restoration:

K-5 Post, per G.L.O. Notes.

B. Description of corner evidence found and/or method applied in restoring or reestablishing corner:

K-5 Corner common to Sec. 11, 12, 13 & 14, T. 4 N., R. 11 E. Found Iron Rod 1/2" inside of 1-1/2" Pipe. Fence lines North, South and West. North fence line is only 15' long. Replaced Found Iron Rod and Iron Pipe with Concrete Monument and Brass Cap #22445. This corner has been accepted by the peer group established under Act 345 of P.A. 1990 and is a careful and faithful perpetuation of the position of the original corner.


Previously Recorded in L. 5982, P. 109 (0); L. 6415, P. 567 (3); and L. 7550, P. 796(4) of Oakland County Records.

(n) Indicates the number of references that confirm this corner by dimensional tie.

C. Description of monument for corner and accessories established to perpetuate locating the position of the corner:

K-5 Corner common to Sec. 11, 12, 13 & 14, T. 4 N., R. 11 E. Set Concrete Monument and Brass Cap #22445. Fence lines North, South and West. North fence line is only 15' long.

- S. 71° E. 32.61' Set P.K. Nail and Disc #22445 in S. face of twin 16" Oak.
- N. 57° E. 54.90' Set P.K. Nail and Disc #22445 in N.W. face of 14" Oak.
- N. 15° E. 6.99' Set P.K. Nail and Disc #22445 in E. face of 24" Oak.
- S. 09° W. 24.76' Set P.K. Nail and Disc #22445 in E. face of twin 4" Cherry.

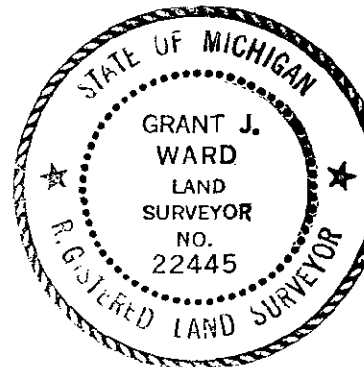

Signed by [Signature]  
Surveyor's Michigan License No. 22445

Date November 3, 1994

93-1010