

**SURVEY &
REMONUMENTATION**

LIBER **15213** PG. **127**

JAN 20 95 011268

MAY - 1 1995

LAND CORNER RECORDATION CERTIFICATE
Filing Requirement of Act 74, Mich. P.A. 1970

OK - T. SMITH

93-1010
For corners in

COMMISSION

Oakland
(County)

Located In: Oakland Corner Code ##

- | | | | | | |
|------------------------------------|---|-----------|---|------------|------------|
| 1. Public Land Survey | T | <u>4N</u> | R | <u>11E</u> | <u>K-8</u> |
| | T | _____ | R | _____ | _____ |
| | T | _____ | R | _____ | _____ |
| | T | _____ | R | _____ | _____ |
| 2. Property Controlling in Section | S | _____ | T | _____ | R |
| | S | _____ | T | _____ | R |
| 3. Miscellaneous Property in Sec. | S | _____ | T | _____ | R |
| | S | _____ | T | _____ | R |

\$ 9.00 MISCELLANEOUS RECORDING
\$ 2.00 REMONUMENTATION
20 JAN 95 8:09 A.M. RECEIPT# 12B
PAID RECORDED - OAKLAND COUNTY
LYNN D. ALLEN, CLERK/REGISTER OF DEEDS
Compliance with
ACT 345, P.A. 1990

APPROVED ON: 12-07-94
OAKLAND COUNTY REMONUMENTATION
PEER GROUP COMMITTEE
Register of Deeds Stamp & File Number

4. Lot No. _____, Recorded Plat _____
5. Private Claims _____

I, Grant J. Ward, RLS, in a field survey on October 18, 19 93, do hereby certify that under requirements of P.A. 74, Michigan P.A. of 1970, the corner points mentioned in lines 1 and 2 above were in conformance with regulations and rules therefore as required in the current manual of survey instructions of the United States Department of the Interior, Bureau of Land Management or by a decree of a Court of Law and/or that the corner points mentioned in lines 3, 4 and 5 above were in conformance with the rules of the Michigan Board of Land Surveyors or by a Decree of a Court of Law; established, re-established, monumented, re-monumented, recovered, found as expressed below:

NOTE: Not more than 4 corners, all in the same town and range, may be recorded on this certificate.

	A	B	C	D	E	F	G	H	I	J	K	L	I
2	6		5		4		3		2		1		
3													
4	7		8		9		10		11		12		
5													
6	18		17		16		15		14		13		
7													
8	19		20		21		22		23		24		
9													
10	30		29		28		27		26		25		
11													
12	31		32		33		34		35		36		
13													

A. Description of original monument and accessories and/or subsequent restoration:

K-8 Post, per G.L.O. Notes.

B. Description of corner evidence found and/or method applied in restoring or reestablishing corner:

K-8 Corner common to Sec. 23 and 24, T. 4 N., R. 11 E. Found (broken) Monument in the Centerline of Hadden Road and 23' North of the Centerline of Gunn Road. Set Brass Cap #22445 on Found (broken) Monument. This corner location is a careful and faithful perpetuation of the position of the original corner.


Previously Recorded in L. 5998, P. 549 (1); and L. 10341, P. 882 (2) of Oakland County Records.

(n) Indicates the number of references that confirm this corner by dimensional tie.

C. Description of monument for corner and accessories established to perpetuate locating the position of the corner:

K-8 Corner common to Sec. 23 and 24, T. 4 N., R. 11 E. Set Brass Cap #22445 on Found (broken) Monument.

- N. 88° W. 28.29' Set P.K. Nail & Brass Disc #22445 in S. face of 24" Oak.
- N. 18° E. 63.25' Set P.K. Nail & Brass Disc #22445 in W. face of twin 22" Cherry.
- S. 22° E. 53.68' Set P.K. Nail & Brass Disc #22445 in W. face of 34" Ash.
- S. 03° E. 65.90' Found Concrete Monument.

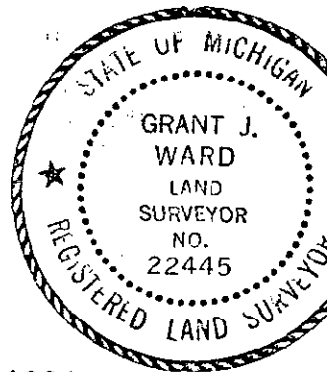

Signed by _____

Date December 15, 1994

Surveyor's Michigan License No. 22445

93-1010