

SURVEY & REMONUMENTATION

LIBER 15213 PG. 131

JAN 20 95 011270

MAY - 1 1995

OK - T. SMITH

LAND CORNER RECORDATION CERTIFICATE

93-1010
For corners in

COMMISSION Filing Requirement of Act 74, Mich. P.A. 1970

\$ 9.00 MISCELLANEOUS RECORDING
\$ 2.00 REMONUMENTATION
20 JAN 95 8:09 A.M. RECEIPT# 12B
PAID RECORDED - OAKLAND COUNTY
LYNN D. ALLEN, CLERK/REGISTER OF DEEDS

Compliance with
ACT 345, P.A. 1990

APPROVED ON: 12-19-94
OAKLAND COUNTY REMONUMENTATION
PEER GROUP COMMITTEE
Register of Deeds Stamp & File Number

Oakland (County) Located In: Oakland Corner Code #

1. Public Land Survey	T <u>4</u> N	R <u>11</u> E	<u>K-11</u>
	T <u> </u>	R <u> </u>	<u> </u>
	T <u> </u>	R <u> </u>	<u> </u>
	T <u> </u>	R <u> </u>	<u> </u>
2. Property Controlling in Section	S <u> </u>	T <u> </u>	R <u> </u>
	S <u> </u>	T <u> </u>	R <u> </u>
3. Miscellaneous Property in Sec.	S <u> </u>	T <u> </u>	R <u> </u>
	S <u> </u>	T <u> </u>	R <u> </u>

4. Lot No. , Recorded Plat

5. Private Claims

	A	B	C	D	E	F	G	H	I	J	K	L	I
2	6	5	4	3	2	1							
3													
4	7	8	9	10	11	12							
5													
6	18	17	16	15	14	13							
7													
8	19	20	21	22	23	24							
9													
10	30	29	28	27	26	25							
11													
12	31	32	33	34	35	36							
13													

I, Grant J. Ward, RLS in a field survey on November 17, 1994, do hereby certify that under requirements of P.A. 74, Michigan P.A. of 1970, the corner points mentioned in lines 1 and 2 above were in conformance with regulations and rules therefore as required in the current manual of survey instructions of the United States Department of the Interior, Bureau of Land Management or by a decree of a Court of Law and/or that the corner points mentioned in lines 3, 4 and 5 above were in conformance with the rules of the Michigan Board of Land Surveyors or by a Decree of a Court of Law; established, re-established, monumented, re-monumented, recovered, found as expressed below:

NOTE: Not more than 4 corners, all in the same town and range, may be recorded on this certificate.

A. Description of original monument and accessories and/or subsequent restoration:

K-11 Post, per G.L.O. Notes.

B. Description of corner evidence found and/or method applied in restoring or reestablishing corner:

K-11 Corner common to Sec. 25, 26, 35 and 36, T. 4 N., R. 11 E. Set Concrete Monument and Brass Cap #22445 at the Intersection of East/West fence line and line between K-10 and K-12. This corner location is a careful and faithful re-establishment of the position of the original corner.


Previously Recorded in L. 5961, P. 573 (0, Addison Township) of Oakland County Records.

(n) Indicates the number of references that confirms this corner by dimensional tie.

C. Description of monument for corner and accessories established to perpetuate locating the position of the corner:

K-11 Corner common to Sec. 25, 26, 35 and 36, T. 4 N., R. 11 E. Set Concrete Monument and Brass Cap #22445.

- N. 10° E. 29.08' Set P.K. Nail & Brass Disc #22445 in E. face of 10" Oak.
- N. 45° E. 24.35' Set P.K. Nail & Brass Disc #22445 in W. face of 12" Oak.
- S. 75° E. 17.52' Set P.K. Nail & Brass Disc #22445 in NE. face of 48" Oak.
- S. 30° W. 30.82' Set P.K. Nail & Brass Disc #22445 in NW. face of 12" Ash.

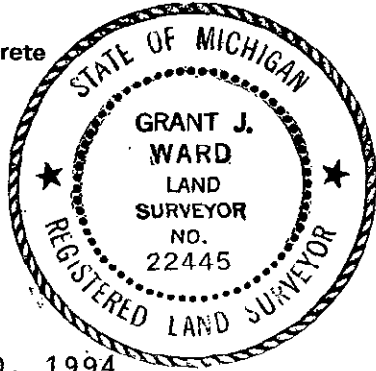

Signed by [Signature]
Surveyor's Michigan License No. 22445

Date December 20, 1994