

**SURVEY & REMONUMENTATION**

MAY - 1 1995

LIBER 15213 PG 133

JAN 20 1995 011271

OK - T. SMITH

93-1010

**COMMISSION**

**LAND CORNER RECORDATION CERTIFICATE**

Filing Requirement of Act 74, Mich. P.A. 1970

\$ 9.00 MISCELLANEOUS RECORDING

\$ 2.00 REMONUMENTATION

20 JAN 95 8:09 A.M. RECEIPT# 12B  
PAID RECORDED - OAKLAND COUNTY  
LYNN D. ALLEN, CLERK/REGISTER OF DEEDS

For corners in

Oakland

(County)

Located In: Oakland

Corner Code #

- |                                    |   |           |   |            |             |
|------------------------------------|---|-----------|---|------------|-------------|
| 1. Public Land Survey              | T | <u>4N</u> | R | <u>11E</u> | <u>K-12</u> |
|                                    | T | ___       | R | ___        | ___         |
|                                    | T | ___       | R | ___        | ___         |
|                                    | T | ___       | R | ___        | ___         |
| 2. Property Controlling in Section | S | ___       | T | ___        | ___         |
|                                    | S | ___       | T | ___        | ___         |
| 3. Miscellaneous Property in Sec.  | S | ___       | T | ___        | ___         |
|                                    | S | ___       | T | ___        | ___         |

Compliance with ACT 345, P.A. 1990

APPROVED ON: 12-19-94  
OAKLAND COUNTY REMONUMENTATION  
PEER GROUP COMMITTEE  
Register of Deeds Stamp & File Number

4. Lot No. \_\_\_\_\_, Recorded Plat \_\_\_\_\_  
5. Private Claims \_\_\_\_\_

I, Grant J. Ward, RLS in a field survey on November 23, 19 94, do hereby certify that under requirements of P.A. 74, Michigan P.A. of 1970, the corner points mentioned in lines 1 and 2 above were in conformance with regulations and rules therefore as required in the current manual of survey instructions of the United States Department of the Interior, Bureau of Land Management or by a decree of a Court of Law and/or that the corner points mentioned in lines 3, 4 and 5 above were in conformance with the rules of the Michigan Board of Land Surveyors or by a Decree of a Court of Law; established, re-established, monumented, re-monumented, recovered, found as expressed below:

**NOTE: Not more than 4 corners, all in the same town and range, may be recorded on this certificate.**

A	B	C	D	E	F	G	H	I	J	K	L	I
2	6	5	4	3	2	1						
3												
4	7	8	9	10	11	12						
5												
6	18	17	16	15	14	13						
7												
8	19	20	21	22	23	24						
9												
10	30	29	28	27	26	25						
11												
12	31	32	33	34	35	36						
13												

A. Description of original monument and accessories and/or subsequent restoration:

K-12 Post, per G.L.O. Notes.

B. Description of corner evidence found and/or method applied in restoring or reestablishing corner:


K-12 Corner common to Sec. 35 and 36, T. 4 N., R. 11 E. Set Concrete Monument and Brass Cap #22445 on line with fence line running North and South and midway between K-11 and K-13. Corner is 15' +/- South of the Centerline of two-track trail. Fence line runs North and South. This corner location is a careful and faithful re-establishment of the position of the original corner.

Previously Unrecorded in Oakland County Records.

C. Description of monument for corner and accessories established to perpetuate locating the position of the corner:

K-12 Corner common to Sec. 35 and 36, T. 4 N., R. 11 E. Set Concrete Monument and Brass Cap #22445.

- N. 25° E. 33.45' Set P.K. Nail & Brass Disc #22445 in E. face of 24" Oak.
- N. 40° W. 45.91' Set P.K. Nail & Brass Disc #22445 in SW. face of 12" Cherry.
- Due West 41.70' Set P.K. Nail & Brass Disc #22445 in N. face of 18" Oak.
- S. 10° W. 13.15' Set P.K. Nail & Brass Disc #22445 in W. face of 24" Pine.

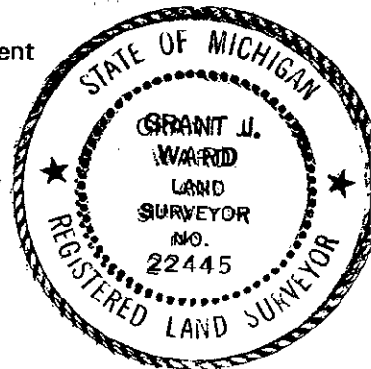

Signed by [Signature]

Date December 20, 1994

Surveyor's Michigan License No. 22445