

**SURVEY &
REMONUMENTATION**

JAN 20 95 011272

LIBER 15213 PG 135

93-1010
For corners in
Oakland
(County)
MAY - 1 1995
COMMISSION
LAND CORNER RECORDATION CERTIFICATE
Filing Requirement of Act 74, Mich. P.A. 1970

OK - T. SMITH

\$ 9.00 MISCELLANEOUS RECORDING
20 JAN 95 8:09 A.M. RECEIPT# 12B
PAID RECORDED - OAKLAND COUNTY
LYNN D. ALLEN, CLERK/REGISTER OF DEEDS
\$ 2.00 REMONUMENTATION
Compliance with
ACT 345, P.A. 1990

APPROVED ON: 12-19-94
OAKLAND COUNTY REMONUMENTATION
PEER GROUP COMMITTEE
Register of Deeds Stamp & File Number

1. Public Land Survey	T	<u>4</u> N	R	<u>11</u> E	<u>K-13</u>
	T	_____	R	_____	_____
	T	_____	R	_____	_____
	T	_____	R	_____	_____
2. Property Controlling in Section	S	_____	T	_____	R
	S	_____	T	_____	R
3. Miscellaneous Property in Sec.	S	_____	T	_____	R
	S	_____	T	_____	R

4. Lot No. _____, Recorded Plat _____
5. Private Claims _____

I, Grant J. Ward, RLS, in a field survey on May 2, 1994, do hereby certify that under requirements of P.A. 74, Michigan P.A. of 1970, the corner points mentioned in lines 1 and 2 above were in conformance with regulations and rules therefore as required in the current manual of survey instructions of the United States Department of the Interior, Bureau of Land Management or by a decree of a Court of Law and/or that the corner points mentioned in lines 3, 4 and 5 above were in conformance with the rules of the Michigan Board of Land Surveyors or by a Decree of a Court of Law; established, re-established, monumented, re-monumented, recovered, found as expressed below:

NOTE: Not more than 4 corners, all in the same town and range, may be recorded on this certificate.

	A	B	C	D	E	F	G	H	I	J	K	L	I
2	6	5	4	3	2	1							
3													
4	7	8	9	10	11	12							
5													
6	18	17	16	15	14	13							
7													
8	19	20	21	22	23	24							
9													
10	30	29	28	27	26	25							
11													
12	31	32	33	34	35	36							
13													

A. Description of original monument and accessories and/or subsequent restoration:

K-13 Post, per G.L.O. Notes.

B. Description of corner evidence found and/or method applied in restoring or reestablishing corner:

K-13 Corner common to Sec. 35, 36 and the Town Line, T. 4 N., R. 11 E. Found 1" Iron Bar 3' +/- North of the Centerline of Mead Road, 0.4' below Road surface. Fence runs to the South. This corner location is a careful and faithful perpetuation of the position of the original corner.


Previously Recorded in L. 5892, P. 249 (2); and L. 7654, P. 149 (1) of Oakland County Records.
Previously Recorded in L. 10279, P. 723 (K-1 in Avon Twp.) (3); and L. 11376, P. 558 (K-1 in Avon Twp.) (4) of Oakland County Records.

(n) Indicates the number of references that confirms this corner by dimensional tie.

C. Description of monument for corner and accessories established to perpetuate locating the position of the corner:

K-13 Corner common to Sec. 35, 36 and the Town Line, T. 4 N., R. 11 E. Set Iron Rod and Brass Cap #22445 adjoining Found 1" Iron Bar.

Due South	28.22'	Set P.K. Nail & Brass Disc #22445 in W. face of fence post.
S. 40° W.	31.49'	Set P.K. Nail & Brass Disc #22445 in NW. face of 6" Oak.
N. 65° W.	27.65'	Set P.K. Nail & Brass Disc #22445 in SW. face of 10" Cherry.
N. 40° E.	32.19'	Set P.K. Nail & Brass Disc #22445 in SE. face of 38" Oak.

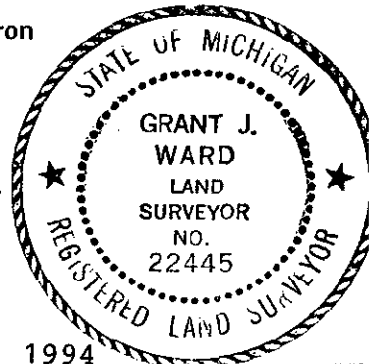

Signed by [Signature]
Surveyor's Michigan License No. 22445

Date December 20, 1994