

MAY - 1 1995

LAND CORNER RECORDATION CERTIFICATE

Compliance with ACT 345, P.A. 1990

93-1010

COMMISSION Filing Requirement of Act 74, Mich. P.A. 1970

APPROVED ON: 12-19-94 OAKLAND COUNTY REMONUMENTATION PEER GROUP COMMITTEE

For corners in

Oakland

(County)

Located In: Oakland Corner Code #

- 1. Public Land Survey T 4N R 11E L-1
2. Property Controlling in Section S T R
3. Miscellaneous Property in Sec. S T R

\$ 9.00 MISCELLANEOUS RECORDING \$ 2.00 REMONUMENTATION 15 NOV 94 9:02 A.M. RECEIPT# 14B PAID RECORDED - OAKLAND COUNTY LYNN D. ALLEN, CLERK/REGISTER OF DEEDS

OK - T. SMITH

Register of Deeds Stamp & File Number

- 4. Lot No. , Recorded Plat
5. Private Claims

I, Grant J. Ward, RLS in a field survey on November 3, 19 93 do hereby certify that under requirements of P.A. 74, Michigan P.A. of 1970, the corner points mentioned in lines 1 and 2 above were in conformance with regulations and rules therefore as required in the current manual of survey instructions of the United States Department of the Interior, Bureau of Land Management or by a decree of a Court of Law and/or that the corner points mentioned in lines 3, 4 and 5 above were in conformance with the rules of the Michigan Board of Land Surveyors or by a Decree of a Court of Law; established, re-established, monumented, re-monumented, recovered, found as expressed below:

Grid table with columns A-L and rows 1-13. A dot is marked in the top right corner (L1).

NOTE: Not more than 4 corners, all in the same town and range, may be recorded on this certificate.

A. Description of original monument and accessories and/or subsequent restoration:

L-1 None, not set according to G.L.O. Notes.

Handwritten signature/initials.

B. Description of corner evidence found and/or method applied in restoring or reestablishing corner:

L-1 Corner common to Sec. 1 & Town Line, T. 4 N., R. 11 E. Found Iron Rod 5/8" in Monument Box, 2' North of Centerline of Romeo and 37' +/- East of Centerline of gravel road to a gravel pit. Set Iron Rod and Brass Cap #22445 in Monument Box. This corner has been accepted by the peer group established under Act 345 of P.A. 1990 and although not established by an original government survey, is accepted as the best available evidence of the position of the corner.


Previously Recorded in L. 9673, P. 254 (3) of Oakland County Records.

(n) Indicates the number of references that confirm this corner by dimensional tie.

C. Description of monument for corner and accessories established to perpetuate locating the position of the corner:

L-1 Corner common to Sec. 1 & Town Line, T. 4 N., R. 11 E. Set Iron Rod and Brass Cap #22445 in Monument Box, 2' North of Centerline of Romeo and 37' +/- East of Centerline of gravel road to a gravel pit.

- Due South 34.02' Set P.K. Nail and Disc #22445 in W. face of Utility Pole.
S. 55° W. 76.08' Found P.K. Nail and Disc #17623 in N.W. face of 26" Poplar.
N. 44° W. 85.27' Set P.K. Nail and Disc #22445 in N.E. face of Utility Pole.
N. 14° E. 46.51' Set P.K. Nail and Disc #22445 in W. face of Utility Pole.
S. 02° E. 33.00' Found Monument.

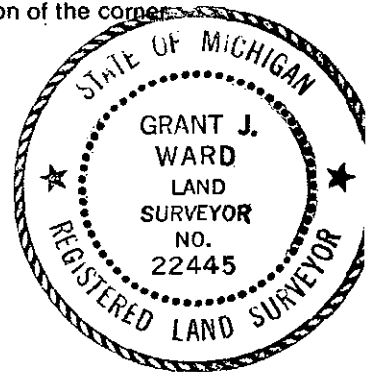

Signed by [Signature]

Date November 3, 1994

Surveyor's Michigan License No. 22445

93-1010