

MAY - 1 1995

COMMISSION LAND CORNER RECORDATION CERTIFICATE
Filing Requirement of Act 74, Mich. P.A. 1970

Compliance with ACT 345, P.A. 1990

93-1010
For corners in

Oakland (County)

Located in: Oakland Corner Code #

APPROVED ON: 12-19-94
OAKLAND COUNTY REMONUMENTATION PEER GROUP COMMITTEE
\$ 9.00 MISCELLANEOUS RECORDING
\$ 2.00 REMONUMENTATION
15 NOV 94 9:02 A.M. RECEIPT# 14B
PAID RECORDED - OAKLAND COUNTY
LYNN D. ALLEN, CLERK/REGISTER OF DEEDS

OK - T. SMITH

Register of Deeds Stamp & File Number

- 1. Public Land Survey T 4N R 11E L-3
T ___ R ___
T ___ R ___
T ___ R ___
- 2. Property Controlling S ___ T ___ R ___
in Section S ___ T ___ R ___
- 3. Miscellaneous S ___ T ___ R ___
Property in Sec. S ___ T ___ R ___

- 4. Lot No. _____, Recorded Plat _____
- 5. Private Claims _____

I, Grant J. Ward, RLS, in a field survey on October 26, 1993, do hereby certify that under requirements of P.A. 74, Michigan P.A. of 1970, the corner points mentioned in lines 1 and 2 above were in conformance with regulations and rules therefore as required in the current manual of survey instructions of the United States Department of the Interior, Bureau of Land Management or by a decree of a Court of Law and/or that the corner points mentioned in lines 3, 4 and 5 above were in conformance with the rules of the Michigan Board of Land Surveyors or by a Decree of a Court of Law; established, re-established, monumented, re-monumented, recovered, found as expressed below:

NOTE: Not more than 4 corners, all in the same town and range, may be recorded on this certificate.

A. Description of original monument and accessories and/or subsequent restoration:

L-3 Post, per G.L.O. Notes.

B. Description of corner evidence found and/or method applied in restoring or reestablishing corner:

L-3 Corner common to Sec. 1 & 12, T. 4 N., R. 11 E. Found Iron Rod 1/2", 2' North of Centerline of Predmore Road, 0.70' below Road surface. Tree lines to North and South. Set Iron Rod and Brass Cap #22445, adjoining Found Iron Rod. This corner has been accepted by the peer group established under Act 345 of P.A. 1990 and is a careful and faithful perpetuation of the position of the original corner.


Previously Recorded in L. 6393, P. 58 (3); L. 7354, P. 684 (3); and L. 11202, P. 586(4) of Oakland County Records.

(n) Indicates the number of references that confirm this corner by dimensional tie.

C. Description of monument for corner and accessories established to perpetuate locating the position of the corner:

L-3 Corner common to Sec. 1 & 12, T. 4 N., R. 11 E. Set Iron Rod and Brass Cap #22445, 2' North of Centerline of Predmore Road. Tree lines to North and South.

- N. 33° W. 32.32' Found P.K. Nail in S.W. face of 22" Walnut.
- N. 04° E. 18.61' Found P.K. Nail in E. face of 18" Walnut.
- S. 12° E. 25.29' Set P.K. Nail and Disc #22445 in N.E. face of 24" Walnut.
- S. 61° W. 40.35' Set P.K. Nail and Disc #22445 in N.W. face of 22" Maple.

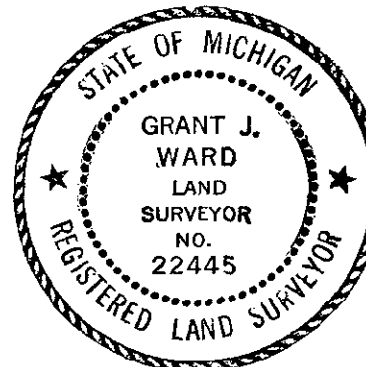

Signed by [Signature]

Date November 3, 1994

Surveyor's Michigan License No. 22445