SURVEY & REMONUMENTATION

MAY - 1 1995

COMMISSION

LIBER 15095 PG 068

Nov 1 594295405

Compliance with ACT 345, P.A. 1990

APPROVED ON: 12-19-94
OAKLAND COUNTY REMONUMENTATION PEER GROUP COMMITTEE

93-1010

LAND CORNER RECORDATION CERTIFICATE

Filing Requirement of Act 74, Mich. P.A. 1970

For corners in Oakland (County)

Located In: Oakland Corner Code #

$ 9.00 MISCELLANEOUS RECORDING
$ 2.00 REMONUMENTATION
13 NOV 94 9:02 A.M. RECEIPT# 148
PAID RECORDED - OAKLAND COUNTY
LYNN D. ALLEN, CLERK/REGISTER OF DEEDS

OK - T. SMITH

Register of Deeds Stamp & File Number

1. Public Land Survey T 4N R 11E L-5
   T ___ R ___
   T ___ R ___
   T ___ R ___
2. Property Controlling S ___ T ___ R ___
   in Section S ___ T ___ R ___
3. Miscellaneous S ___ T ___ R ___
   Property in Sec. S ___ T ___ R ___

4. Lot No. _____, Recorded Plat _____
5. Private Claims _____

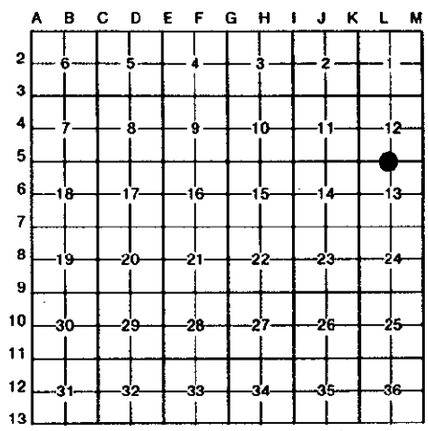

I, Grant J. Ward, RLS, in a field survey on October 25, 1993, do hereby certify that under requirements of P.A. 74, Michigan P.A. of 1970, the corner points mentioned in lines 1 and 2 above were in conformance with regulations and rules therefore as required in the current manual of survey instructions of the United States Department of the Interior, Bureau of Land Management or by a decree of a Court of Law and/or that the corner points mentioned in lines 3, 4 and 5 above were in conformance with the rules of the Michigan Board of Land Surveyors or by a Decree of a Court of Law; established, re-established, monumented, re-monumented, recovered, found as expressed below:

NOTE: Not more than 4 corners, all in the same town and range, may be recorded on this certificate.

A. Description of original monument and accessories and/or subsequent restoration:

L-5 Post, per G.L.O. Notes.

B. Description of corner evidence found and/or method applied in restoring or reestablishing corner:

L-5 Corner common to Sec. 12 & 13, T. 4 N., R. 11 E. Found Iron Pipe 1/2", 1.40' South of Centerline of Parks Road, 0.25' below Road surface. Tree line to South. Set Iron Rod and Brass Cap #22445, adjoining Found Iron Pipe. This corner has been accepted by the peer group established under Act 345 of P.A. 1990 and is a careful and faithful perpetuation of the position of the original corner.

Previously Recorded in L. 5982, P. 109 (3); L. 7550, P. 796 (4); L. 7630, P. 311 (2); and L. 11322, P. 807 (4) of Oakland County Records. Also Recorded as Reference No. 55 (2) by the Oakland County Road Commission.

(*n*) Indicates the number of references that confirm this corner by dimensional tie.

C. Description of monument for corner and accessories established to perpetuate locating the position of the corner:

L-5 Corner common to Sec. 12 & 13, T. 4 N., R. 11 E. Set Iron Rod and Brass Cap #22445, 1.40' South of Centerline of Parks Road. Tree line to South.

S. 47° E.	36.47'	Found P.K. Nail in N.E. face of Utility Pole.
S. 10° W.	30.03'	Found P.K. Nail and Disc #17623 in E. face of 12" Locust.
N. 39° W.	25.82'	Found P.K. Nail and Disc in N.E. face of twin 12" Box Elder.
N. 57° E.	49.78'	Found Form Nail and Disc #17623 in N.W. face of Utility Pole.

STATE OF MICHIGAN
GRANT J. WARD
LAND SURVEYOR
NO. 22445
REGISTERED LAND SURVEYOR

Signed by _____ Date November 3, 1994

Surveyor's Michigan License No. 22445

93-1010

FORM APPROVED BY MICHIGAN STATE BOARD OF LAND SURVEYORS, JAN. 28, 1971
REVISED MAY 14, 1975
REVISED JAN., 1983