

**SURVEY &  
REMONUMENTATION**

LIBER 15095 PG 070

Nov 15 94 295406

**OK - T. SMITH**

Compliance with  
ACT 345, P.A. 1990

MAY - 1 1995

**LAND CORNER RECORDATION CERTIFICATE**

93-1010  
For corners in

**COMMISSION Filing Requirement of Act 74, Mich. P.A. 1970**

APPROVED ON: 1-26-94  
OAKLAND COUNTY, REMONUMENTATION  
PEER GROUP COMMITTEE

Oakland Located In: Oakland Corner Code ≠#  
(County)

1. Public Land Survey	T	<u>4N</u>	R	<u>11E</u>	<u>L-7</u>
	T		R		
	T		R		
	T		R		
	T		R		
2. Property Controlling in Section	S		T	R	
	S		T	R	
3. Miscellaneous Property in Sec.	S		T	R	
	S		T	R	

\$ 9.00 MISCELLANEOUS RECORDING  
\$ 2.00 REMONUMENTATION  
15 NOV 94 9:02 A.M. RECEIPT# 14B  
PAID RECORDED - OAKLAND COUNTY  
LYNN D. ALLEN, CLERK/REGISTER OF DEEDS

Register of Deeds Stamp & File Number

4. Lot No. \_\_\_\_\_, Recorded Plat \_\_\_\_\_  
5. Private Claims \_\_\_\_\_

	A	B	C	D	E	F	G	H	I	J	K	L	M
2	6		5		4		3		2		1		
3													
4	7		8		9		10		11		12		
5													
6	18		17		16		15		14		13		
7													
8	19		20		21		22		23		24		
9													
10	30		29		28		27		26		25		
11													
12	31		32		33		34		35		36		
13													

I, Grant J. Ward, RLS, in a field survey on October 20, 19 93, do hereby certify that under requirements of P.A. 74, Michigan P.A. of 1970, the corner points mentioned in lines 1 and 2 above were in conformance with regulations and rules therefore as required in the current manual of survey instructions of the United States Department of the Interior, Bureau of Land Management or by a decree of a Court of Law and/or that the corner points mentioned in lines 3, 4 and 5 above were in conformance with the rules of the Michigan Board of Land Surveyors or by a Decree of a Court of Law; established, re-established, monumented, re-monumented, recovered, found as expressed below:

**NOTE: Not more than 4 corners, all in the same town and range, may be recorded on this certificate.**

A. Description of original monument and accessories and/or subsequent restoration:

L-7 Post, per G.L.O. Notes.

*Handwritten signature/initials*

B. Description of corner evidence found and/or method applied in restoring or reestablishing corner:

L-7 Corner common to Sec. 13 & 24, T. 4 N., R. 11 E. Found Iron Pipe 1/2", in intersection of Buell and Hixon Roads. Corner is 0.60' below Road surface. Fence line to East. Set Iron Rod and Brass Cap #22445, adjoining Found Iron Pipe. This corner has been accepted by the peer group established under Act 345 of P.A. 1990 and is a careful and faithful perpetuation of the position of the original corner.


Previously Recorded in L. 6195, P. 264 (2); L. 7283, P. 218 (2); L. 7630, P. 310 (2); and L. 9678, P. 461 (4) of Oakland County Records.

(n) Indicates the number of references that confirm this corner by dimensional tie.

C. Description of monument for corner and accessories established to perpetuate locating the position of the corner:

L-7 Corner common to Sec. 13 & 24, T. 4 N., R. 11 E. Set Iron Rod and Brass Cap #22445, in intersection of Buell and Hixon Roads. Fence line to East.

- S. 59° W. 49.59' Set P.K. Nail and Disc #22445 in N.W. face of twin 4" Cherry.
- N. 40° W. 79.10' Set P.K. Nail and Disc #22445 in S.W. face of Utility Pole.
- N. 37° E. 36.37' Set P.K. Nail and Disc #22445 in S.E. face of 14" Elm.
- S. 82° E. 27.20' Set P.K. Nail and Disc #22445 in S. face of Utility Pole.
- East 3.80' Found Iron Bar.
- N. 83° E. 3.80' Found 1/4" Iron Rod.

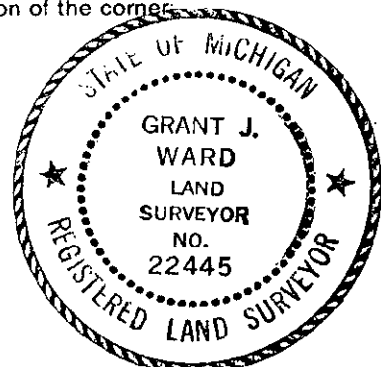

Signed by [Signature] Date November 3, 1994  
Surveyor's Michigan License No. 22445