

**SURVEY &
REMONUMENTATION**

LIBER 15095pc072

Nov 15 94 295407

Compliance with
ACT 345, P.A. 1990

MAY - 1 1995

LAND CORNER RECORDATION CERTIFICATE

APPROVED ON: 1-26-94
OAKLAND COUNTY REMONUMENTATION
PEER GROUP COMMITTEE

93-1010
For corners in

COMMISSION Filing Requirement of Act 74, Mich. P.A. 1970

Oakland Located In: Oakland Corner Code #
(County)

- | | | |
|------------------------------------|---|-------------|
| 1. Public Land Survey | T <u>4</u> N R <u>11</u> E | <u>L-9</u> |
| | T <u> </u> R <u> </u> | <u> </u> |
| | T <u> </u> R <u> </u> | <u> </u> |
| | T <u> </u> R <u> </u> | <u> </u> |
| 2. Property Controlling in Section | S <u> </u> T <u> </u> R <u> </u> | <u> </u> |
| | S <u> </u> T <u> </u> R <u> </u> | <u> </u> |
| 3. Miscellaneous Property in Sec. | S <u> </u> T <u> </u> R <u> </u> | <u> </u> |
| | S <u> </u> T <u> </u> R <u> </u> | <u> </u> |
4. Lot No. , Recorded Plat
5. Private Claims

\$ 9.00 MISCELLANEOUS RECORDING
\$ 2.00 REMONUMENTATION
15 NOV 94 9:02 A.M. RECEIPT# 14B
PAID RECORDED - OAKLAND COUNTY
LYNN D. ALLEN, CLERK/REGISTER OF DEEDS

OK - T. SMITH

Register of Deeds Stamp & File Number

I, Grant J. Ward, RLS, in a field survey on November 11, 19 93, do hereby certify that under requirements of P.A. 74, Michigan P.A. of 1970, the corner points mentioned in lines 1 and 2 above were in conformance with regulations and rules therefore as required in the current manual of survey instructions of the United States Department of the Interior, Bureau of Land Management or by a decree of a Court of Law and/or that the corner points mentioned in lines 3, 4 and 5 above were in conformance with the rules of the Michigan Board of Land Surveyors or by a Decree of a Court of Law; established, re-established, monumented, re-monumented, recovered, found as expressed below:

NOTE: Not more than 4 corners, all in the same town and range, may be recorded on this certificate.

	A	B	C	D	E	F	G	H	I	J	K	L	M
2	6	5	4	3	2	1							
3													
4	7	8	9	10	11	12							
5													
6	18	17	16	15	14	13							
7													
8	19	20	21	22	23	24							
9													
10	30	29	28	27	26	25							
11													
12	31	32	33	34	35	36							
13													

A. Description of original monument and accessories and/or subsequent restoration:

L-9 Post, per G.L.O. Notes.

file

B. Description of corner evidence found and/or method applied in restoring or reestablishing corner:

L-9 Corner common to Sec. 24 & 25, T. 4 N., R. 11 E. Found Iron Rod and Cap #30085 in swamp, 13' East of stream, 15' South of stream and 4.0' North of East-West fence. Set 5' Iron Rod and Brass Cap #22445, adjoining Found Iron Rod and Cap #30085. This corner has been accepted by the peer group established under Act 345 of P.A. 1990 and is a careful and faithful perpetuation of the position of the original corner.


Previously Recorded in L. 11170, P. 546 (4) of Oakland County Records.

(n) Indicates the number of references that confirm this corner by dimensional tie.

C. Description of monument for corner and accessories established to perpetuate locating the position of the corner:

L-9 Corner common to Sec. 24 & 25, T. 4 N., R. 11 E. Set 5' Iron Rod and Brass Cap #22445 in swamp, 13' East of stream, 15' South of stream and 4.0' North of East-West fence.

- Due South 4.60' Set P.K. Nail and Disc #22445 in W. face of 6" Elm.
- Due West 16.33' Found P.K. Nail in N. face of 16" Elm.
- N. 44° W. 36.92' Found P.K. Nail in S.W. face of 12" Oak.
- N. 23° W. 24.38' Found P.K. Nail in W. face of 10" Elm.

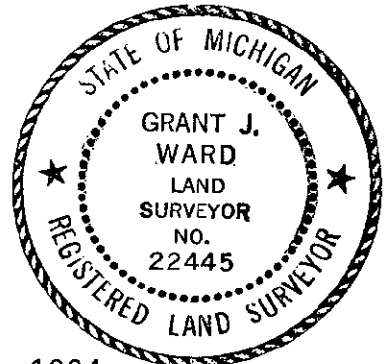

Signed by [Signature]

Date November 3, 1994

Surveyor's Michigan License No. 22445