

MAY - 1 1995

**LAND CORNER RECORDATION CERTIFICATE**

Compliance with ACT 345, P.A. 1990

93-1010 COMMISSION  
For corners in Oakland

Filing Requirement of Act 74, Mich. P.A. 1970

APPROVED ON: 1-26-94  
OAKLAND COUNTY REMONUMENTATION PEER GROUP COMMITTEE

	(County)	Located In: Oakland	Corner Code <u>77</u>
1. Public Land Survey	T <u>4N</u> R <u>11E</u>	<u>M-6</u>	
	T _____ R _____	_____	
	T _____ R _____	_____	
	T _____ R _____	_____	
2. Property Controlling in Section	S _____ T _____ R _____	_____	
	S _____ T _____ R _____	_____	
3. Miscellaneous Property in Sec.	S _____ T _____ R _____	_____	
	S _____ T _____ R _____	_____	

\$ 9.00 MISCELLANEOUS RECORDING  
\$ 2.00 REMONUMENTATION  
15 NOV 94 9:03 A.M. RECEIPT# 148  
PAID RECORDED - OAKLAND COUNTY  
LYNN D. ALLEN, CLERK/REGISTER OF DEEDS

**OK - T. SMITH**

Register of Deeds Stamp & File Number

4. Lot No. \_\_\_\_\_, Recorded Plat \_\_\_\_\_  
5. Private Claims \_\_\_\_\_

A	B	C	D	E	F	G	H	I	J	K	L	M
2	6	5	4	3	2	1						
3												
4	7	8	9	10	11	12						
5												
6	18	17	16	15	14	13						
7												
8	19	20	21	22	23	24						
9												
10	30	29	28	27	26	25						
11												
12	31	32	33	34	35	36						
13												

I, Grant J. Ward, RLS, in a field survey on October 25, 19 93, do hereby certify that under requirements of P.A. 74, Michigan P.A. of 1970, the corner points mentioned in lines 1 and 2 above were in conformance with regulations and rules therefore as required in the current manual of survey instructions of the United States Department of the Interior, Bureau of Land Management or by a decree of a Court of Law and/or that the corner points mentioned in lines 3, 4 and 5 above were in conformance with the rules of the Michigan Board of Land Surveyors or by a Decree of a Court of Law; established, re-established, monumented, re-monumented, recovered, found as expressed below:

**NOTE: Not more than 4 corners, all in the same town and range, may be recorded on this certificate.**

A. Description of original monument and accessories and/or subsequent restoration:

M-6 Post, per G.L.O. Notes.

*Handwritten signature/initials*

B. Description of corner evidence found and/or method applied in restoring or reestablishing corner:

M-6 Corner common to Sec. 13 & Range Line, T. 4 N., R. 11 E. Found Iron Pipe 1/2" in Monument Box, 4.5' South of Centerline of Inwood and in Centerline of Dequindre Road, 0.90' below Road surface. Set Iron Rod and Brass Cap #22445, adjoining Found Iron Pipe. This corner has been accepted by the peer group established under Act 345 of P.A. 1990 and is a careful and faithful perpetuation of the position of the original corner.


Previously Recorded in L. 6908, P. 426 (0); and L. 8485, P. 841 (2) of Oakland County Records.

(n) Indicates the number of references that confirm this corner by dimensional tie.

C. Description of monument for corner and accessories established to perpetuate locating the position of the corner:

M-6 Corner common to Sec. 13 & Range Line, T. 4 N., R. 11 E. Set Iron Rod and Brass Cap #22445 in Monument Box, 4.5' South of Centerline of Inwood and in Centerline of Dequindre Road.

- N. 39° W. 55.84' Set P.K. Nail and Disc #22445 in S.W. face of 36" Maple.
- N. 66° E. 69.78' Set P.K. Nail and Disc #22445 in S.E. face of Utility Pole.
- S. 19° E. 52.14' Set P.K. Nail and Disc #22445 in E. face of 6" Cherry.
- S. 59° W. 43.26' Set P.K. Nail and Disc #22445 in N.W. face of 3" Box Elder.

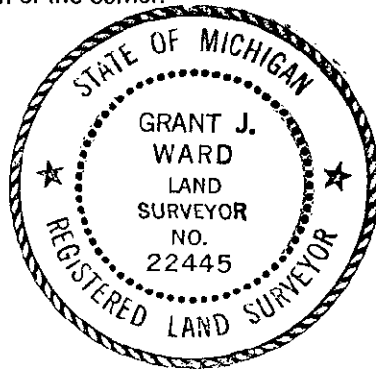

Signed by [Signature] Date November 3, 1994

Surveyor's Michigan License No. 22445