

SURVEY & REMONUMENTATION

LIBER 15095 pc 084

Nov 15 94 295413

MAY - 1 1995

Compliance with ACT 345, P.A. 1990

93-1010 COMMISSION

LAND CORNER RECORDATION CERTIFICATE

Filing Requirement of Act 74, Mich. P.A. 1970

APPROVED ON: 1-26-94
OAKLAND COUNTY REMONUMENTATION PEER GROUP COMMITTEE

Oakland (County) Located In: Oakland Corner Code #

- 1. Public Land Survey T 4N R 11E M-7
- T _____ R _____
- T _____ R _____
- T _____ R _____
- 2. Property Controlling S _____ T _____ R _____
- in Section S _____ T _____ R _____
- 3. Miscellaneous S _____ T _____ R _____
- Property in Sec. S _____ T _____ R _____

\$ 9.00 MISCELLANEOUS RECORDING
\$ 2.00 REMONUMENTATION
15 NOV 94 9:03 A.M. RECEIPT# 14B
PAID RECORDED - OAKLAND COUNTY
LYNN D. ALLEN, CLERK/REGISTER OF DEEDS

OK - T. SMITH

Register of Deeds Stamp & File Number

- 4. Lot No. _____, Recorded Plat _____
- 5. Private Claims _____

	A	B	C	D	E	F	G	H	I	J	K	L	A
2	6		5		4		3		2		1		
3													
4	7		8		9		10		11		12		
5													
6	16		17		18		19		20		21		22
7													
8	19		20		21		22		23		24		
9													
10	30		29		28		27		26		25		
11													
12	31		32		33		34		35		36		
13													

I, Grant J. Ward, RLS, in a field survey on November 10, 1993, do hereby certify that under requirements of P.A. 74, Michigan P.A. of 1970, the corner points mentioned in lines 1 and 2 above were in conformance with regulations and rules therefore as required in the current manual of survey instructions of the United States Department of the Interior, Bureau of Land Management or by a decree of a Court of Law and/or that the corner points mentioned in lines 3, 4 and 5 above were in conformance with the rules of the Michigan Board of Land Surveyors or by a Decree of a Court of Law; established, re-established, monumented, re-monumented, recovered, found as expressed below:

NOTE: Not more than 4 corners, all in the same town and range, may be recorded on this certificate.

A. Description of original monument and accessories and/or subsequent restoration:

M-7 Post, per G.L.O. Notes.

Handwritten signature/initials

B. Description of corner evidence found and/or method applied in restoring or reestablishing corner:

M-7 Corner common to Sec. 13, 24 & Range Line, T. 4 N., R. 11 E. Found Iron Rod 1/2" in rocks, 1' East of Fence Post, Fence to West and South. Replaced Found Iron Rod with Concrete Monument and Brass Cap #22445. This corner has been accepted by the peer group established under Act 345 of P.A. 1990 and is a careful and faithful perpetuation of the position of the original corner.


Previously Recorded in L. 8485, P. 841 (3) of Oakland County Records. Previously Recorded in L. 2496, P. 760 (3) in Macomb County Records.

(n) Indicates the number of references that confirm this corner by dimensional tie.

C. Description of monument for corner and accessories established to perpetuate locating the position of the corner:

M-7 Corner common to Sec. 13, 24 & Range Line, T. 4 N., R. 11 E. Set Concrete Monument and Brass Cap #22445 in rocks, 1' East of Fence Post, Fence to West and South.

- S. 26° W. 8.91' Set P.K. and Disc #22445 in E. face of 4" Oak.
- N. 10° E. 5.72' Set P.K. and Disc #22445 in W. face of 8" Oak.
- N. 59° E. 14.89' Set P.K. and Disc #22445 in S.E. face of 4" Oak.
- S. 82° E. 15.41' Set P.K. and Disc #22445 in S. face of 5" Oak.

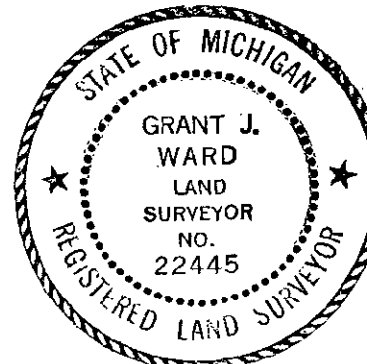

Signed by [Signature] Date November 3, 1994

Surveyor's Michigan License No. 22445

93-1010