

LAND CORNER RECORDATION CERTIFICATE

FILING REQUIREMENT OF ACT 74, MICH. P.A.1970

Oakland County

FOR CORNERS OF--	LOCATED IN--	CORNER CODE NUMBER
1. PUBLIC LAND SURVEY <u>25</u> T. <u>5</u> N. <u>X</u> , R. <u>7</u> E. <u>W</u>		K 11 - L11, I11, K12
2. PROPERTY CONTROLLING IN SECTION _____, T. _____, S. _____, R. _____, E. _____, W. _____		<i>copied from Co. records in ENG. DIV file 24-96017</i>
3. MISCELLANEOUS PROPERTY IN SECTION _____, T. _____, S. _____, R. _____, E. _____, W. _____		
4. LOT NO. _____, RECORDED PLAT _____		
5. PRIVATE CLAIMS _____		REGISTER OF DEEDS STAMP AND FILING NUMBER

I, Gary C. Bilow do hereby certify that under requirements of P.A. 74, Michigan P.A. of 1970, the corner points mentioned in lines 1 and 2 above (identified with circles on index code diagram—over) were, in a field survey on March 10, 1982, established, re-established, monumented, re-monumented, recovered or restored as expressed below and in conformance with regulations and rules therefore as required in the current manual of survey instructions of the United States Department of the Interior, Bureau of Land Management or by a decree of a court of law. Furthermore, that the corner points mentioned in lines 3, 4 and 5 above were, in a field survey on _____ 19____, found, recovered, restored, established or re-established as expressed below and in conformance with the rules of the Michigan State Board of Registration for Land Surveyors or, by a Decree of a Court of law:

A. Description of original monument and accessories and/or subsequent restoration:

<p>GLO set post 1823 Witnesses W.O. 11, N1°W, 5.94' W.O. 4, N77-1/2°E, 15.18'</p>	<p>1849 Sloan Cooley County Surveyor Witnesses W.O. 20, S37°E, 17.32' W.O. 24, N16-1/2°W, 56.10'</p>
---	---

B. Description of corner evidence found and/or method applied in restoring or re-establishing corner:

Found split steel post, 2" diameter, 4 feet high, set in concrete. Dug around and found long stone (4" x 4" x 15" high), tilted slightly, adjacent to concrete 8 inches below surface. Old stump NE matches GLO call for 4" White Oak. Barbed wire embedded in trees (old fence lines) North and East.

Straightened stone and accepted for corner location.


C. Description of monument for corner and accessories established to perpetuate locating the position of the corner:

Replaced stone with 1/2" rebar encased in 4" concrete cylinder with cast aluminum cap (MI Dept. of Natural Resources monument)

Witnessed

S55°E, 14.39', spike and tag in 8" Hickory
 S83°E, 5.81', spike and tag in 5" Ash
 S3°W, 11.70', spike and tag in 7" Ash
 N38°E, 1.15', split in 2" vertical steel post near base of steep bank, 20 feet East of lakeshore

SIGNED BY Gary C. Bilow DATE 3/12/82
 SURVEYOR'S MICHIGAN REGISTRATION NO. 26453

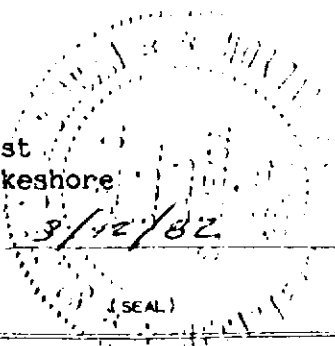

FOR STATE AND UNITED STATES AGENCIES:

SIGNED BY _____ DATE _____
CHIEF OF SURVEY PARTY
 APPROVED AND SIGNED BY _____ DATE _____
MICHIGAN REGISTERED LAND SURVEYOR (SEAL)

SURVEYOR'S MICHIGAN REGISTRATION NO. _____