

LAND CORNER RECORDATION CERTIFICATE

FILING REQUIREMENT OF ACT 74, MICH. P.A.1970

FOR CORNERS OF--:	LOCATED IN--:	CORNER CODE NUMBER
1. PUBLIC LAND SURVEY <u>25</u>	T. <u>5</u> N. <u>7</u> E. <u>7</u>	M-9
2. PROPERTY CONTROLLING IN SECTION _____	T. _____ N. _____ S. _____ R. _____ W. _____	_____
3. MISCELLANEOUS PROPERTY IN SECTION _____	T. _____ N. _____ S. _____ R. _____ W. _____	_____
4. LOT NO. _____, RECORDED PLAT _____		
5. PRIVATE CLAIMS _____		

REGISTER OF DEEDS STAMP AND FILING NUMBER

I, Donald L. Bissell, do hereby certify that under requirements of P.A. 74, Michigan P.A. of 1970, the corner points mentioned in lines 1 and 2 above were, in a field survey on October, 1984, established, re-established, monumented, re-monumented, recovered or restored as expressed below and in conformance with regulations and rules therefore as required in the current manual of survey instructions of the United States Department of the Interior, Bureau of Land Management or by a decree of a court of law. Furthermore, that the corner points mentioned in lines 3, 4 and 5 above were, in a field survey on _____, 19____, found, recovered, restored, established or re-established as expressed below and in conformance with the rules of the Michigan State Board of Registration for Land Surveyors or, by a Decree of a Court of law:

- A. Description of original monument and accessories and/or subsequent restoration:
- M-9 NE Corner
 - 3/4" pipe set from existing property lines by M.D.O.T. 1959
 - all witnesses taken out by construction of I-75
 - West - 6.77' - 8" B.E.
 - North - 3.90' - 11" B.E.
 - S30°W - 24.15' - 9" Elm
 - South - 22.45' - 18" B.E.
- B. Description of corner evidence found and/or method applied in restoring or re-establishing corner:
- M-9 NE Corner
 - Found iron in monument box at record distance from M.D.O.T. Plans.
 - This corner is 145.5' short of the G.L.O. jog and is not in harmony with corners to the north and south on the town line.
- C. Description of monument for corner and accessories established to perpetuate locating the position of the corner:
- M-9 NE Corner
 - Iron in monument box 1' below gravel shoulder midway around.
 - N. Bound ramp of I-75 at Grange Hall road; south side ramp.
 - N20°E - 94.71' - 14" Oak
 - N51°E - 95.18' - 6" W. Ash
 - N40°E - 4.6' - Edge of bit ramp
 - N82°W - 48.6' - Catch basin.


SIGNED BY _____ DATE _____

SURVEYOR'S MICHIGAN REGISTRATION NO. _____ (SEAL)

FOR STATE AND UNITED STATES AGENCIES:

SIGNED BY _____ DATE _____

APPROVED AND SIGNED BY Donald L. Bissell DATE _____
MICHIGAN REGISTERED LAND SURVEYOR

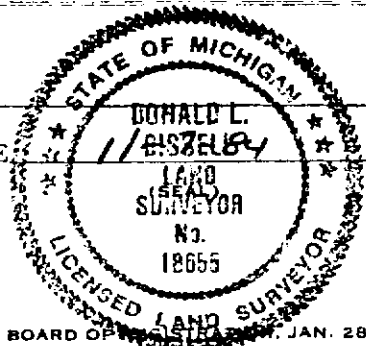

SURVEYOR'S MICHIGAN REGISTRATION NO. 18655