

LAND CORNER RECORDATION CERTIFICATE
Filing Requirement of Act 74, Mich. P.A. 1970

1897

For corners in

LIBER 20945 PAGE 492
\$7.00 MISC RECORDING
\$2.00 REMONUMENTATION
01/04/2000 07:37:44 A.M. RECEIPT# 342
PAID RECORDED - OAKLAND COUNTY
G. WILLIAM CADDELL, CLERK/REGISTER OF DEEDS

Oakland Located In: Holly Township Corner Code # A-2
(county)
1. Public Land Survey T 5N R 7E _____
T _____ R _____
T _____ R _____
T _____ R _____
2. Property Controlling S _____ T _____ R _____
in Section S _____ T _____ R _____
3. Miscellaneous S _____ T _____ R _____
Property in Sec. S _____ T _____ R _____

Compliance with
ACT 345, P.A. 1990
APPROVED ON: 8-4-99 JL
OAKLAND COUNTY REMONUMENTATION
PEER GROUP COMMITTEE
Register of Deeds Stamp & File Number

MAR 21 2000

4. Lot No. _____, Recorded Plat _____ SECTION _____
5. Private Claims _____

	A	B	C	D	E	F	G	H	I	J	K	L	M
2	6	5	4	3	2	1							
3													
4	7	8	9	10	11	12							
5													
6	13	17	16	15	14	13							
7													
8	19	20	21	22	23	24							
9													
10	30	29	28	27	26	25							
11													
12	31	32	33	34	35	36							
13													

I, James E. Kovas, in a field survey on July 19, 1999, do hereby certify that under requirements of P.A. 74, Michigan P.A. of 1970, the corner points mentioned in lines 1 and 2 above were in conformance with regulations and rules therefore as required in the current manual of survey instructions of the United States Department of the Interior, Bureau of Land Management or by a decree of a Court of Law and/or that the corner points mentioned in lines 3, 4 and 5 above were in conformance with the rules of the Michigan Board of Land Surveyors or by a Decree of a Court of Law; established, re-established, monumented, re-monumented, recovered, found as expressed below:

NOTE: Not more than 4 corners, all in the same town and range, may be recorded on this certificate.

A. Description of original monument and accessories and/or subsequent restoration:

A-2
1816 - G.L.O., Alex Holmes, D.S., no post set
1994 - Set 30" Bernsten Stainless steel tube with brass remon cap

Distances: A-2 to A-1 = A-1 not set, in lake
A-2 to A-3 = 2746.82' (Wade-Trim, Consumers 1998)
A-2 to C-2 = 5371.09' (Wade-Trim, Consumers 1998)

B. Description of corner evidence found and/or method applied in restoring or reestablishing corner:

A-2 Found Genesee County Brass Remon monument


This corner was surveyed and presented by Wade-Trim and accepted by Genesee Peer Review in 1994 for M-2 of Fenton Township, Genesee County. Evidence was searched for indicating whether a double corner existed at this corner. No field or record evidence was located. We talked with Gould Engineering who completed the 1958 survey and they said that their records indicatd a common corner for the West 1/4 corner of Section 6 Holly Township and the East 1/4 corner of Section 1, Fenton Township.

We recommend that the Genesee corner M-2 be accepted as the common corner of Holly A-2.

C. Description of monument for corner and accessories established to perpetuate locating the position of the corner:

A-2 Found brass cap (Geness County) in centerline road

WIT: South 37.85' Set 60d nail in power pole
N 83.03 E Set 60d nail in 16" Maple
North 50.42' Set 60d nail in power pole
N 51.03' W Set 60d nail in 6" Elm

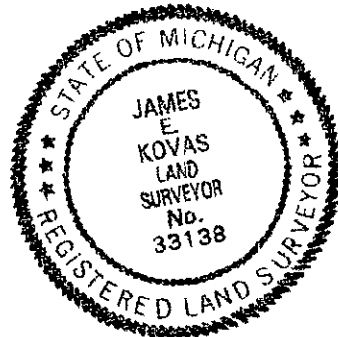

Signed by James E. Kovas

Date 12/22/99

Surveyor's Michigan License No. 33138