

LAND CORNER RECORDATION CERTIFICATE
Filing Requirement of Act 74, Mich. P.A. 1970

1902

For corners in

Oakland
(county)

Located In: Corner Code #

Holly Township
T 5N R 7E A-7
T ___ R ___ SURVEY &
T ___ R ___ RECORDATION
T ___ R ___
2. Property Controlling S ___ T ___ R ___
in Section S ___ T ___ R ___
3. Miscellaneous S ___ T ___ R ___
Property in Sec. S ___ T ___ R ___
MAR 21 2000
SECTION

LIBER 20945 PAGE 497
\$7.00 MISC RECORDING
\$2.00 REMONUMENTATION
01/04/2000 07:37:46 A.M. RECEIPT# 342
PAID RECORDED - OAKLAND COUNTY
G. WILLIAM CADDELL, CLERK/REGISTER OF DEEDS

Compliance with
ACT 345, P.A. 1990

APPROVED ON: 8-9-99 JJK
OAKLAND COUNTY REMONUMENTATION
PEER GROUP COMMITTEE
Register of Deeds Stamp & File Number

4. Lot No. _____, Recorded Plat _____

5. Private Claims _____

I, James E. Kovas, in a field survey on 7-27, 99, do hereby certify that under requirements of P.A. 74, Michigan P.A. of 1970, the corner points mentioned in lines 1 and 2 above were in conformance with regulations and rules therefore as required in the current manual of survey instructions of the United States Department of the Interior, Bureau of Land Management or by a decree of a Court of Law and/or that the corner points mentioned in lines 3, 4 and 5 above were in conformance with the rules of the Michigan Board of Land Surveyors or by a Decree of a Court of Law; established, re-established, monumented, re-monumented, recovered, found as expressed below:

	A	B	C	D	E	F	G	H	I	J	K	L	M
2	6		5		4		3		2		1		
3													
4	7		8		9		10		11		12		
5													
6	16		17		18		19		20		21		
7													
8	19		20		21		22		23		24		
9													
10	30		29		28		27		26		25		
11													
12	31		32		33		34		35		36		
13													

NOTE: Not more than 4 corners, all in the same town and range, may be recorded on this certificate.

A. Description of original monument and accessories and/or subsequent restoration:
A-7

1816 - G.L.O., Alex Holmes, D.S., post set
1994 - Wade-Trim (M-7 LCRC 1994 Genesee Remon corner) found concrete monument, set Genesee remon cap

Distances: A-7 to A-6 = 2635.49' (Wade-Trim, 1999)

A-7 to A-8 = 2641.40' (Wade-Trim, 1999)

A-7 to B-7 = B-7 is in a Lake

A-7 to M-7 (Fenton) = 5.94' North

B. Description of corner evidence found and/or method applied in restoring or reestablishing corner:


A-7 No corner monumentation was found at A-7 Holly. No record evidence was found of this corner.

As per Oakland Peer Review committee instructions, this section corner was set at the GLO closing distance (9 links) 5.94' south of the Fenton Township corner.

C. Description of monument for corner and accessories established to perpetuate locating the position of the corner:

A-7 Set concrete monument per peer location on Township line.

WIT: S 20 E 23.53' Set P.K. nail w/tag #33138 East face 8" Oak
S 80 W 29.08' Set P.K. nail w/tag #33138 East face 6" Oak
N 30 W 45.65' Set P.K. nail w/tag #33138 East face 8" Oak
North 5.94' Genesee County Monument

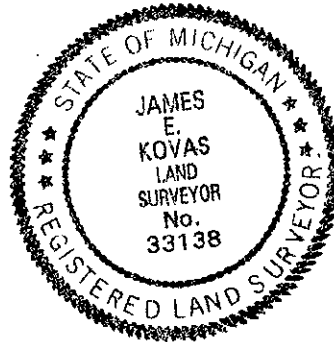

Signed by James E. Kovas

Date 12/23/99

Surveyor's Michigan License No. 33138