

LAND CORNER RECORDATION CERTIFICATE
Filing Requirement of Act 74, Mich. P.A. 1970

LIBER 20945 PAGE 498
\$7.00 MISC RECORDING
\$2.00 REMONUMENTATION
01/04/2000 07:37:46 A.M. RECEIPT# 342
PAID RECORDED - OAKLAND COUNTY
G. WILLIAM CADDELL, CLERK/REGISTER OF DEEDS

For corners in

Oakland (county) Located In: Corner Code #
Holly Township
1. Public Land Survey T 5N R 7E A-8
T R
T R SURVEY &
T R RECONSTITUTION
2. Property Controlling S T R
in Section S T R
3. Miscellaneous S T R
Property in Sec. S T R
MAR 21 2000
SECTION

Compliance with
ACT 345, P.A. 1990
PROVED ON: 8-1-99 JIL
LAND COUNTY REMONUMENTATION
PEER GROUP COMMITTEE
Register of Deeds Stamp & File Number

- 4. Lot No. , Recorded Plat
- 5. Private Claims

I, James E. Kovas, in a field survey on December 17, 1999, do hereby certify that under requirements of P.A. 74, Michigan P.A. of 1970, the corner points mentioned in lines 1 and 2 above were in conformance with regulations and rules therefore as required in the current manual of survey instructions of the United States Department of the Interior, Bureau of Land Management or by a decree of a Court of Law and/or that the corner points mentioned in lines 3, 4 and 5 above were in conformance with the rules of the Michigan Board of Land Surveyors or by a Decree of a Court of Law; established, re-established, monumented, re-monumented, recovered, found as expressed below:

	A	B	C	D	E	F	G	H	I	J	K	L	M
2	6		5		4		3		2		1		
3													
4	7		8		9		10		11		12		
5													
7													
8	19		20		21		22		23		24		
9													
10	30		29		28		27		26		25		
11													
12	31		32		33		34		35		36		
13													

NOTE: Not more than 4 corners, all in the same town and range, may be recorded on this certificate.

A. Description of original monument and accessories and/or subsequent restoration:

- A-8
1816 - G.L.O., Alex Holmes, D.S., no post set
1973 - Donald McKeever #17628 (LCRC Liber 6128, Page 581) found 1/2" iron rod, set 3/4" pipe over the 1/2" rod on side of bank
1994 - Wade-Trim (M-8 LCRC 1994 Genesee Romon corner) found concrete monument, set Genesee remon cap

- Distances: A-8 to A-7 = 2641.40' (Wade-Trim, 1999)
A-8 to A-9 = 2723.54' (Wade-Trim, 1999)
A-8 to M-8 (Fenton) = 21.67' north (Wade-Trim, 1999)

B. Description of corner evidence found and/or method applied in restoring or reestablishing corner:

A-8 Found 3/4" iron pipe on side of bank.

WITNESSES FOUND:


North 22.05' to 3/4" pipe, East 1/4 corner Section 24, T5N, R6E, Fenton Found 21.67' Remon

As per Oakland Peer Review, this quarter corner will be moved onto the Fenton Township line. This will place the new corner 0.58' east of the found 3/4" iron pipe. The 3/4" iron pipe now becomes a controlling property corner (CPC).

C. Description of monument for corner and accessories established to perpetuate locating the position of the corner:

A-8 Set concrete monument 0.58' East of 3/4" pipe.

- WIT: N 10 E 7.30' Set P.K. nail w/tag #33138 30" Oak
N 50 W 10.40' Set P.K. nail w/tag #33138 20" Oak
N 25 E 7.39' Set P.K. nail w/tag #33138 14" Oak
S 32 W 57.13' Set P.K. nail w/tag #33138 light pole

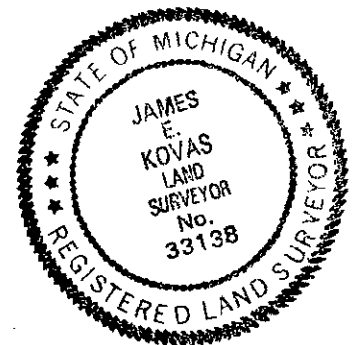

Signed by James E. Kovas

Date 12/23/99

Surveyor's Michigan License No. 33138