

LAND CORNER RECORDATION CERTIFICATE
Filing Requirement of Act 74, Mich. P.A. 1970

For corners in

Oakland Located In: Holly Township Corner Code # A-13
 (county)

1. Public Land Survey T 5N R 7E A-13
 T R
 T R
 T R

2. Property Controlling S T R
 in Section S T R

3. Miscellaneous S T R
 Property in Sec. S T R

1908
 LIBER 20945 PAGE 503
 \$7.00 MISC RECORDING
 \$2.00 REMONUMENTATION
 01/04/2000 07:37:46 A.M. RECEIPT# 342
 PAID RECORDED - OAKLAND COUNTY
 G. WILLIAM CABBELL, CLERK/REGISTER OF DEEDS
 ACT 345, P.A. 1990
 APPROVED ON: 3-31-99 JS
 OAKLAND COUNTY REMONUMENTATION
 PEER GROUP COMMITTEE
 Register of Deeds Stamp & File Number

SECTION

4. Lot No. _____, Recorded Plat _____
 5. Private Claims _____

I, James E. Kovas, in a field survey on July 28, 1998, do hereby certify that under requirements of P.A. 74, Michigan P.A. of 1970, the corner points mentioned in lines 1 and 2 above were in conformance with regulations and rules therefore as required in the current manual of survey instructions of the United States Department of the Interior, Bureau of Land Management or by a decree of a Court of Law and/or that the corner points mentioned in lines 3, 4 and 5 above were in conformance with the rules of the Michigan Board of Land Surveyors or by a Decree of a Court of Law; established, re-established, monumented, re-monumented, recovered, found as expressed below:

A	B	C	D	E	F	G	H	I	J	K	L
2	6	5	4	3	2	1					
3											
4	7	8	9	10	11	12					
5											
6	16	17	18	15	14	13					
7											
8	19	20	21	22	23	24					
9											
10	30	29	28	27	26	25					
11											
12	31	32	33	34	35	36					
13											

NOTE: Not more than 4 corners, all in the same town and range, may be recorded on this certificate.

A. Description of original monument and accessories and/or subsequent restoration:

A-13
1816 - G.L.O., Alex Holmes, D.S., set post

Distances: A-13 to A-12 = 2668.27'
 A-13 to C-13 = 5322.21' (Wade-Trim, 1998)
 A-13 to B-13 = 2651.24'

B. Description of corner evidence found and/or method applied in restoring or reestablishing corner:


A-13 Found remon monument.

This corner was surveyed and presented by Wade-Trim accepted by Genesee Peer Review in 1994 for M-14 of Fenton Township, Genesee County. The corner was also surveyed by JCK for Rose Township, Oakland County.

C. Description of monument for corner and accessories established to perpetuate locating the position of the corner:

A-13 Found 1/2" iron. Set remon cap on top.

WIT: N 70 W 70.43' Set Remon tag w/mag nail in South face 24" Hickory
 N 55 E 32.09' Set Remon tag w/mag nail in Northwest face 18" Oak
 S 15 E 30.33' Set Remon tag w/mag nail in West face 11" Ash
 West 215.00' Found concrete monument w/Remon cap C-1 Rose Township

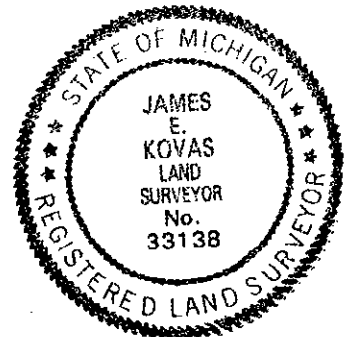

Signed by James E. Kovas Date 12/22/99