

LAND CORNER RECORDATION CERTIFICATE  
Filing Requirement of Act 74, Mich. P.A. 1970

1909

For corners in

Oakland Located In: Corner Code #  
(county)  
Holly Township  
1. Public Land Survey T 5N R 7E B-3  
T R  
T R  
T R  
2. Property Controlling S T  
in Section S T R  
3. Miscellaneous S T R  
Property in Sec. S T R

LIBER 20945 PAGE 504  
\$7.00 MISC RECORDING  
\$2.00 REMONUMENTATION  
01/04/2000 07:37:46 A.M. RECEIPT# 342  
PAID RECORDED - OAKLAND COUNTY  
G. WILLIAM CARDELL, CLERK/REGISTER OF DEEDS

Compliance with  
ACT 345, P.A. 1990

RECEIVED ON: 11-2-99 JA  
OAKLAND COUNTY REMONUMENTATION  
PEER GROUP COMMITTEE  
Register of Deeds Stamp & File Number

SECTION

4. Lot No. \_\_\_\_\_, Recorded Plat \_\_\_\_\_  
5. Private Claims \_\_\_\_\_

I, James E. Kovas In a field survey on November 4, 1999,  
do hereby certify that under requirements of P.A. 74, Michigan P.A. of 1970, the corner points  
mentioned in lines 1 and 2 above were in conformance with regulations and rules therefore as  
required in the current manual of survey instructions of the United States Department of the Interior,  
Bureau of Land Management or by a decree of a Court of Law and/or that the corner points  
mentioned in lines 3, 4 and 5 above were in conformance with the rules of the Michigan Board of  
Land Surveyors or by a Decree of a Court of Law; established, re-established, monumented,  
re-monumented, recovered, found as expressed below:

	A	B	C	D	E	F	G	H	I	J	K	L	P
2	6		5		4		3		2		1		
3													
4	7		8		9		10		11		12		
5													
6	16		17		18		15		14		13		
7													
8	19		20		21		22		23		24		
9													
10	30		29		28		27		26		25		
11													
12	31		32		33		34		35		36		
13													

NOTE: Not more than 4 corners, all in the same town and range, may be recorded on this certificate.

A. Description of original monument and accessories and/or subsequent restoration:

B-3  
1816 - G.L.O., Alex Holmes, D.S., set post

Distances: B-3 to A-3 = 2663.83' (Wade-Trim, 1999)

B-3 to C-3 = 2678.07' (Wade-Trim, 1999)  
B-3 to C-3 = 2677.41' (Tax map)  
B-3 to C-3 = 2640.00' (40 chains GLO)

A-3 to C-3 = 5341.90' (Wade-Trim, 1998)  
A-3 to C-3 = 5351.28' (81.08 chains GLO)

B. Description of corner evidence found and/or method applied in restoring or reestablishing corner:

B-3 Found 1" iron pipe.


This corner falls in swamp. This corner was computed from tax map and tax description distances and angles from the monument at the NE corner (C3) and from property irons found to the south.

Iron found 778.62' south (tax map) 778.62' (computed)  
Iron found at NE corner 2677.41' east (tax map) 2678.07' (computed)

C. Description of monument for corner and accessories established to perpetuate locating the position of the corner:

B-3 Found 1" iron pipe in swamp. Removed and replaced with concrete monument cap #33138.

WIT: S 60 W 64.93' Set P.K. nail w/tag #33138 in 8" Elm  
N 72 W 67.63' Set P.K. nail w/tag #33138 in 18" Oak  
N 26 W 60.65' Set P.K. nail w/tag #33138 in 12" Twin Oak  
S 37 E 47.05' Set P.K. nail w/tag #33138 in 10" dead tree

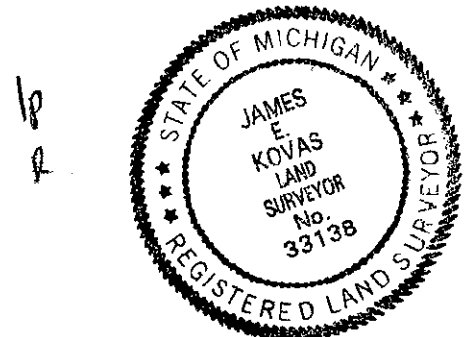

Signed by James E. Kovas Date 12/23/99

Surveyor's Michigan License No. 33138