

LAND CORNER RECORDATION CERTIFICATE
Filing Requirement of Act 74, Mich. P.A. 1970

1912

For corners in

Oakland Located In: Holly Township Corner Code # B-13
(county)

1. Public Land Survey T 5N R 7E B-13
T ___ R ___
T ___ R ___ SURVEY &
T ___ R ___ RESTORATION

2. Property Controlling S ___ T ___
in Section S ___ T ___
3. Miscellaneous S ___ T ___ R ___ MAR 21 2000
Property in Sec. S ___ T ___ R ___

LIBER 20945 PAGE 507
\$7.00 RECORDED
\$2.00 RE-MONUMENTATION
01/03/2000 02:37:36 P.M. RECEIPT# 342
PAID RECORDED - OAKLAND COUNTY
E. HOLMES CORP. CLERK/REGISTER OF DEEDS

APPROVED WITH
ACT 74, P.A. 1999
PROVED ON 6-16-99 JS
OAKLAND COUNTY REMONUMENTATION
PEER GROUP COMMITTEE
Register of Deeds Stamp & File Number

SECTION

4. Lot No. _____, Recorded Plat _____
5. Private Claims _____

I, James E. Kovas, in a field survey on May 4, 1999, do hereby certify that under requirements of P.A. 74, Michigan P.A. of 1970, the corner points mentioned in lines 1 and 2 above were in conformance with regulations and rules therefore as required in the current manual of survey instructions of the United States Department of the Interior, Bureau of Land Management or by a decree of a Court of Law and/or that the corner points mentioned in lines 3, 4 and 5 above were in conformance with the rules of the Michigan Board of Land Surveyors or by a Decree of a Court of Law; established, re-established, monumented, re-monumented, recovered, found as expressed below:

A	B	C	D	E	F	G	H	I	J	K	L
2	6	5	4	3	2	1					
3											
4	7	8	9	10	11	12					
5											
6	18	17	16	15	14	13					
7											
8	19	20	21	22	23	24					
9											
10	30	29	28	27	26	25					
11											
12	31	32	33	34	35	36					
13											

NOTE: Not more than 4 corners, all in the same town and range, may be recorded on this certificate.

A. Description of original monument and accessories and/or subsequent restoration:

B-13
1816 - G.L.O., Alex Holmes, D.S., set post
1982 - Lloyd McGinnis #18999 (LCRC Liber 13438, Page 323) found 1/2" bar

Distances: B-13 to A-13 = 2651.24'
B-13 to C-13 = 2671.15'
B-13 to B-1 = (Rose) 188.80' (west) (Wade-Trim 1999)

B. Description of corner evidence found and/or method applied in restoring or reestablishing corner:

B-13 Found 1/2 iron in old fence.


WITNESSES FOUND:

North 8.01' to 30" Oak	found	8.00'
S 50 E 15.20' to 24" Oak	found	15.00'
N 75 W 8.85' to 12" Oak	found	8.95'
North 8.04' to nail in East side 30" Oak	found	8.00'
N 70 W 8.90' to nail in South side 16" Oak	found	8.95'
S 45 E 15.24' to nail in West side 24" Oak	found	15.00'
West 188.85' to LS cap #10057 (N 1/4 Sec. 6, T4N, R7E)	found	188.90'

C. Description of monument for corner and accessories established to perpetuate locating the position of the corner:

B-13 Found 1/2" iron in old fence line. Removed and replaced with concrete monument Cap #33138.

WIT: North 7.85' Set nail w/Tag #33138 30" Oak
N 48 W 8.95' Set nail w/Tag #33138 in 16" Oak
S 40 W 25.82' Set nail w/Tag #33138 in 12" Oak
S 45 E 15.00' Set nail w/Tag #33138 in 24" Oak
West 188.90' Iron Cap #10057

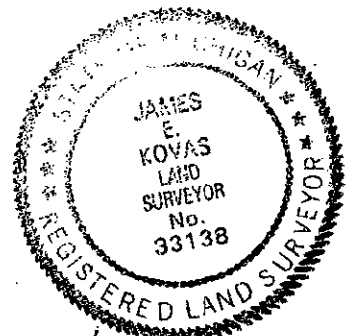

Signed by James E. Kovas Date 12/22/99