

LAND CORNER RECORDATION CERTIFICATE
Filing Requirement of Act 74, Mich. P.A. 1970

1916

For corners in

Oakland
(county)

Located In: Corner Code #

Holly Township

1. Public Land Survey

T 5N R 7E C-4

T ___ R ___

T ___ R ___ SURVEY &

T ___ R ___ RE-ESTABLISHMENT

2. Property Controlling
in Section

S ___
S ___

T ___ R ___
T ___ R ___

MAR 21 2000

3. Miscellaneous
Property in Sec.

S ___
S ___

T ___ R ___
T ___ R ___

SECTION

LIBER 20945 PAGE 511
\$7.00 MISC RECORDING
\$2.00 REMONUMENTATION
01/04/2000 07:37:46 A.M. RECEIPT# 342
PAID RECORDED - OAKLAND COUNTY
G. WILLIAM CABELL, CLERK/REGISTER OF DEEDS

Complies with
ACT 345, P.A. 1990

APPROVED ON: 9-8-99 JIL
OAKLAND COUNTY REMONUMENTATION
TECH GROUP COMMITTEE
Register of Deeds Stamp & File Number

4. Lot No. _____, Recorded Plat _____

5. Private Claims _____

I, James E. Kovas, in a field survey on November 2, 1999, do hereby certify that under requirements of P.A. 74, Michigan P.A. of 1970, the corner points mentioned in lines 1 and 2 above were in conformance with regulations and rules therefore as required in the current manual of survey instructions of the United States Department of the Interior, Bureau of Land Management or by a decree of a Court of Law and/or that the corner points mentioned in lines 3, 4 and 5 above were in conformance with the rules of the Michigan Board of Land Surveyors or by a Decree of a Court of Law; established, re-established, monumented, re-monumented, recovered, found as expressed below:

	A	B	C	D	E	F	G	H	I	J	K	L	M
2													
3													
NOTE: Not more than 4 corners, all in the same town and range, may be recorded on this certificate.

A. Description of original monument and accessories and/or subsequent restoration:
C-4

1816 - G.L.O., Alex Holmes, D.S., set post

Distances: C-4 to C-3 = 2647.29' (Wade-Trim, 1999)

C-4 to C-5 = 2630.39' (Wade-Trim, 1999)

C-4 to C-5 = 2630.12' (tax map)

B. Description of corner evidence found and/or method applied in restoring or reestablishing corner:

C-4 Found 1/2" iron

No witnesses recorded. But the following distances from tax maps and the Alpha survey were checked against irons found.


Iron found at SE corner parcel II-A; 994.87' (M) 994.94' (R) and tax map

Iron found at centerline of Gage Road to west; 1337.04' (M) 1336.38' (R) and tax map

C. Description of monument for corner and accessories established to perpetuate locating the position of the corner:

C-4 Found 1/2" iron in fence line North, South, and West. Removed and replace with concrete monument Cap #33138.

WIT: S 83 E 5.88' Set P.K. nail w/tag #33138 24" Oak
S 26 E 26.36' Set P.K. nail w/tag #33138 20" Oak
S 45 W 19.08' Set P.K. nail w/tag #33138 10" Oak
N 52 W 17.30' Set P.K. nail w/tag #33138 30" Oak

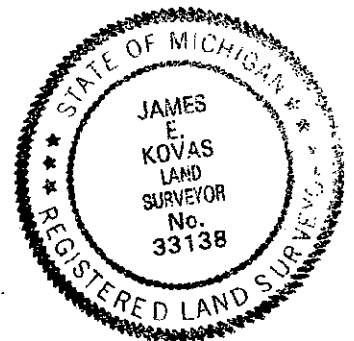

Signed by James E. Kovas

Date 12/22/99

Surveyor's Michigan License No. 33138