

LAND CORNER RECORDATION CERTIFICATE
Filing Requirement of Act 74, Mich. P.A. 1970

1917

For corners in

Oakland Located In: Holly Township Corner Code # C-5
(county)

1. Public Land Survey T 5N R 7E _____
T _____ R _____
T _____ R _____
T _____ R _____

2. Property Controlling S _____ T _____ R _____
in Section S _____ T _____ R _____

3. Miscellaneous S _____ T _____ R _____
Property in Sec. S _____ T _____ R _____

LIBER 20945 PAGE 512
\$7.00 MISC RECORDING
\$2.00 REMONUMENTATION
01/04/2000 07:37:46 A.M. RECEIPT# 342
PAID RECORDED - OAKLAND COUNTY
G. WILLIAM CABDELL, CLERK/REGISTER OF DEEDS

Conformance with
ACT 74, P.A. 1970

RECORDED ON: 3-31-99 JS
OAKLAND COUNTY REMONUMENTATION
REGISTER OF DEEDS STAMP & FILE NUMBER

SURVEY &
RECORDATION
MAR 21 2000

4. Lot No. _____, Recorded Plat _____ SECTION _____

5. Private Claims _____

I, James E. Kovas, in a field survey on July 28, 1998, do hereby certify that under requirements of P.A. 74, Michigan P.A. of 1970, the corner points mentioned in lines 1 and 2 above were in conformance with regulations and rules therefore as required in the current manual of survey instructions of the United States Department of the Interior, Bureau of Land Management or by a decree of a Court of Law and/or that the corner points mentioned in lines 3, 4 and 5 above were in conformance with the rules of the Michigan Board of Land Surveyors or by a Decree of a Court of Law; established, re-established, monumented, re-monumented, recovered, found as expressed below:

NOTE: Not more than 4 corners, all in the same town and range, may be recorded on this certificate.

A. Description of original monument and accessories and/or subsequent restoration:

- C-5
- 1816 - G.L.O., Alex Holmes, D.S., set post
- 1962 - Oakland County Road Commission, found stone
- 1995 - Grant Ward #2245 (LCRC Liber 15193, Page 689) found 1/2" iron rod

- Distances:
- C-5 to C-6 = 2637.04' (Wade-Trim, 1998)
 - C-5 to C-6 = 2637.27' (Newman, 1993)
 - C-5 to C-6 = 2636.87' (Ward, 1994)
 - C-5 to C-4 = 2630.39' (Wade-Trim, 1999)
 - C-5 to C-4 = 2630.12' (Tax map)
 - C-5 to B-5 = 2629.26' (Wade-Trim, 1999)
 - C-5 to B-5 = 2629.34' (Ward, 1994)
 - C-5 to D-5 = 2648.27' (Wade-Trim, 1999)

B. Description of corner evidence found and/or method applied in restoring or reestablishing corner:

C-5 Found 1/2" iron


WITNESSES FOUND:

- S 20 W 21.04' to 15" Boxelder found 21.14'
- S 65 E 28.55' to 15" Boxelder found 28.46'
- S 45 W 21.11' to Set P.K./disc #22445 in NW face 14" Boxelder found 21.14'
- S 75 E 28.45' to Set P.K./disc #22445 in SW face 18" Boxelder found 28.46'
- N 45 E 24.54' to set P.K./disc #22445 in South face 7" Boxelder found 24.52'
- N 45 W 21.72' to set P.K./disc #22445 in NE face 6" Boxelder found 21.69'

C. Description of monument for corner and accessories established to perpetuate locating the position of the corner:

C-5 Found 1/2" iron. Set remon cap #33138.

- WIT:
- N 48 E 41.30' Set P.K./tag #33138 SE face 12" Boxelder
 - S 80 E 43.23' Set P.K./tag #33138 North face 8" Twin Cherry
 - S 45 W 20.93' Set P.K./tag #33138 NW face 14" Boxelder
 - N 53 W 34.25' Set P.K./tag #33138 South face 4" Boxelder
 - North 33.05' Found "T" iron

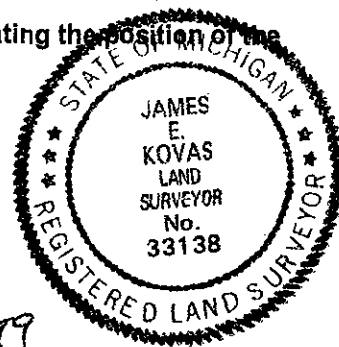

Signed by James E. Kovas

Date 12/22/99

Surveyor's Michigan License No. 33138

