

LAND CORNER RECORDATION CERTIFICATE  
Filing Requirement of Act 74, Mich. P.A. 1970

1918

For corners in

Oakland Located In: Corner Code #  
(county)

1. Public Land Survey Holly Township  
T 5N R 7E C-6  
T     R     SURVEY &  
T     R     RE-  
T     R     STATION

2. Property Controlling S     T     R      
in Section S     T     R     MAR 21 2000

3. Miscellaneous S     T     R      
Property in Sec. S     T     R     SECTION

LIBER 20945 PAGE 513  
\$7.00 MISC RECORDING  
\$2.00 REMONUMENTATION  
01/04/2000 07:37:46 A.M. RECEIPT# 342  
PAID RECORDED - OAKLAND COUNTY  
G. WILLIAM CADDELL, CLERK/REGISTER OF DEEDS

Certified to 7445  
ACT 74, P.A. 1970

APPROVED ON: 3-31-99 JS  
OAKLAND COUNTY REGISTER OF DEEDS  
Register of Deeds Stamp & File Number

4. Lot No. \_\_\_\_\_, Recorded Plat \_\_\_\_\_

5. Private Claims \_\_\_\_\_

I, James E. Kovas, in a field survey on July 30, 1998, do hereby certify that under requirements of P.A. 74, Michigan P.A. of 1970, the corner points mentioned in lines 1 and 2 above were in conformance with regulations and rules therefore as required in the current manual of survey instructions of the United States Department of the Interior, Bureau of Land Management or by a decree of a Court of Law and/or that the corner points mentioned in lines 3, 4 and 5 above were in conformance with the rules of the Michigan Board of Land Surveyors or by a Decree of a Court of Law; established, re-established, monumented, re-monumented, recovered, found as expressed below:

NOTE: Not more than 4 corners, all in the same town and range, may be recorded on this certificate.

A. Description of original monument and accessories and/or subsequent restoration:

- C-6
- 1816 - G.L.O., Alex Holmes, D.S., set post
- 1974 - Ed Anderson #11495 (LCRC Liber 6303, Page 736)
- 1995 - Grant Ward #22445 (LCRC Liber 15193, Page 689 and survey Liber 16485, Page 764) found 1/2" iron rod

- Distances:
- C-6 to C-5 = 2637.04' (Wade-Trim, 1998)
  - C-6 to C-5 = 2637.27' (Newman, 1993)
  - C-6 to C-5 = 2636.87' (Ward, 1994)
  - C-6 to C-7 = 2646.64' (Wade-Trim, 1998)

B. Description of corner evidence found and/or method applied in restoring or reestablishing corner:

C-6 Found 1/2" iron


WITNESSES FOUND:

- |               |   |       |        |
|---------------|---|-------|--------|
| South 34.00'  | to 29" Oak                                    | found | 34.82' |
| N 75 E 48.00' | to 29" Oak                                    | found | 48.61' |
| N 80 E 48.50' | to 30" Walnut                                 | found | 48.61' |
| N 85 E 48.64' | to Set P.K./disc #22445 in South face 36" Oak | found | 48.61' |
| S 70 E 55.69' | to set P.K./disc #22445 in SW face 6" Oak     | found | 55.71' |
| S 5 E 34.84'  | to set P.K./disc #22445 in East face 42" Oak  | found | 34.82' |

C. Description of monument for corner and accessories established to perpetuate locating the position of the corner:

C-6 Found 1/2" iron. Removed and set 5/8" iron and remon cap #33138.

- WIT:
- N 82 E 48.60' Set P.K./tag #33138 South face 42" Oak
  - N 25 E 12.19' Set P.K./tag #33138 East face 24" Walnut
  - S 70 E 55.73' Set P.K./tag #33138 SW face 8" Oak
  - S 05 E 34.90' Set P.K./tag #33138 West face 40" Oak

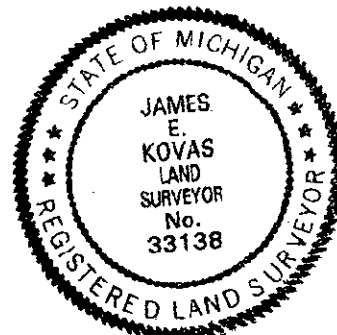

Signed by James E. Kovas

Date 12/22/99

Surveyor's Michigan License No. 33138