

LAND CORNER RECORDATION CERTIFICATE
Filing Requirement of Act 74, Mich. P.A. 1970

1919

LIBER 20945 PAGE 514
\$7.00 MISC RECORDING
\$2.00 REMONUMENTATION
01/04/2000 07:37:46 A.M. RECEIPT# 342
PAID RECORDED - OAKLAND COUNTY
G. WILLIAM CABELL, CLERK/REGISTER OF DEEDS

For corners in

<u>Oakland</u> (county)	Located In:	Corner Code #
1. Public Land Survey	Holly Township	SURVEY & REF C-7
	T 5N R 7E	SECTION
	T R	
	T R	
	T R	MAR 21 2000
2. Property Controlling in Section	S T R	
3. Miscellaneous Property in Sec.	S T R	SECTION

RECEIVED ON 9-8-99 JH
OAKLAND COUNTY RE-MONUMENTATION
REGISTER OF DEEDS
Register of Deeds Stamp & File Number

4. Lot No. _____, Recorded Plat _____
5. Private Claims _____

I, James E. Kovas, in a field survey on August 3, 1998, do hereby certify that under requirements of P.A. 74, Michigan P.A. of 1970, the corner points mentioned in lines 1 and 2 above were in conformance with regulations and rules therefore as required in the current manual of survey instructions of the United States Department of the Interior, Bureau of Land Management or by a decree of a Court of Law and/or that the corner points mentioned in lines 3, 4 and 5 above were in conformance with the rules of the Michigan Board of Land Surveyors or by a Decree of a Court of Law; established, re-established, monumented, re-monumented, recovered, found as expressed below:

A	B	C	D	E	F	G	H	I	J	K	L
2	6	5	4	3	2	1					
3											
4	7	8	9	10	11	12					
5											
6	13	17	18	15	14	13					
7											
8	19	20	21	22	23	24					
9											
10	30	29	28	27	26	25					
11											
12	31	32	33	34	35	36					
13											

NOTE: Not more than 4 corners, all in the same town and range, may be recorded on this certificate.

A. Description of original monument and accessories and/or subsequent restoration:

C-7
1816 - G.L.O., Alex Holmes, D.S., set post
1974 - John Albright #10057 (LCRC Liber 6716, Page 746) found 3/8" iron

Distances: C-7 to C-6 = 2646.64' (Wade-Trim, 1998)
C-7 to C-8 = 2649.58' (Wade-Trim, 1999)
C-7 to B-7 = B7 is in a Lake
C-7 to D-7 = 2633.70' (Wade-Trim, 1999)

B. Description of corner evidence found and/or method applied in restoring or reestablishing corner:

C-7 Found 3/8" iron @ intersection of North and West fence line.

Found iron at SW corner of Lot 24 Iroquois Woods Subdivision No. 2: 920.41' (M) 917.90' (R)


WITNESSES FOUND:

N 75 E 5.70' to 24" Oak found 5.70' center
S 15 W 21.25' to 8" Oak found 21.30'
West 25.30' to 30" Oak Gone

C. Description of monument for corner and accessories established to perpetuate locating the position of the corner:

C-7 Found 3/8" iron at fence line intersection. Removed and set 5/8" x 3' iron and remon cap #33138.

WIT: N 75 E 6.57' Set P.K./tag #33138 SE face 24" Oak
North 40.04' Set P.K./tag #33138 East face 20" Oak
S 15 W 21.30' Set P.K./tag #33138 E face 10" Hickory
S 82 W 63.61' Set P.K./tag #33138 South 34" Oak

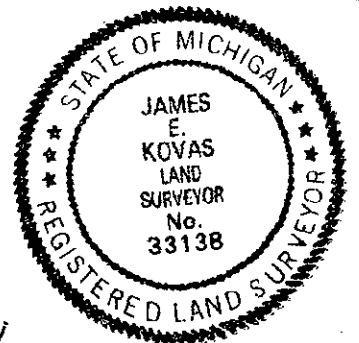

Signed by James E. Kovas

Date 12/22/99

Surveyor's Michigan License No. 33138