

LAND CORNER RECORDATION CERTIFICATE

1920

Filing Requirement of Act 74, Mich. P.A. 1970

LIBER 20945 PAGE 515
 \$7.00 MISC RECORDING
 \$2.00 REMONUMENTATION
 01/04/2000 07:37:46 A.M. RECEIPT# 342
 PAID RECORDED - OAKLAND COUNTY
 G. WILLIAM CADDELL, CLERK/REGISTER OF DEEDS

For corners in

Oakland Located In: Corner Code #
 (county)

Holly Township
 1. Public Land Survey T 5N R 7E C-8
 T R
 T R
 T R
 2. Property Controlling S T R
 in Section S T R
 3. Miscellaneous S T R
 Property in Sec. S T R

REMONUMENTATION
MAR 21 2000
SECTION

Stamp with
 ACT 74, P.A. 1970
 6-16-99 35
 REGISTER OF DEEDS STAMP & FILE NUMBER

4. Lot No. _____, Recorded Plat _____

5. Private Claims _____

I, James E. Kovas, in a field survey on 7-27, 98, do hereby certify that under requirements of P.A. 74, Michigan P.A. of 1970, the corner points mentioned in lines 1 and 2 above were in conformance with regulations and rules therefore as required in the current manual of survey instructions of the United States Department of the Interior, Bureau of Land Management or by a decree of a Court of Law and/or that the corner points mentioned in lines 3, 4 and 5 above were in conformance with the rules of the Michigan Board of Land Surveyors or by a Decree of a Court of Law; established, re-established, monumented, re-monumented, recovered, found as expressed below:

	A	B	C	D	E	F	G	H	I	J	K	L
2												
3												
NOTE: Not more than 4 corners, all in the same town and range, may be recorded on this certificate.

A. Description of original monument and accessories and/or subsequent restoration:

- C-8 1816 - G.L.O., Alex Holmes, D.S., set post
- 1974 - John Albright #10057 (LCRC Liber 6716, Page 746) found 3/4" pipe with 1/2" rerod inside

Distances: C-8 to C-7 = 2649.58' (Wade-Trim, 1998)

C-8 to C-9 = 2705.38' (Wade-Trim, 1999)

B. Description of corner evidence found and/or method applied in restoring or reestablishing corner:

C-8 Found 1/2" iron inside 3/4" pipe.


WITNESSES FOUND:

North	32.30'	to 10" Oak	found	32.25'
N 25 E	32.60'	to 18" Oak	found	32.63'
S 30 W	27.10'	to 15" Walnut	found	27.11'

C. Description of monument for corner and accessories established to perpetuate locating the position of the corner:

C-8 Found 1/2" iron in 3/4" pipe in fence line to north. Removed and replaced with 1/2" iron cap #33138.

- WIT:
- N 40 E 32.63' Set P.K. nail w/tag #33138 18" Oak
 - S 30 E 19.91' Set P.K. nail w/tag #33138 6" Oak
 - S 45 W 27.03' Set P.K. nail w/tag #33138 16" Walnut
 - N 60 W 37.50' Set P.K. nail w/tag #33138 8" Cherry

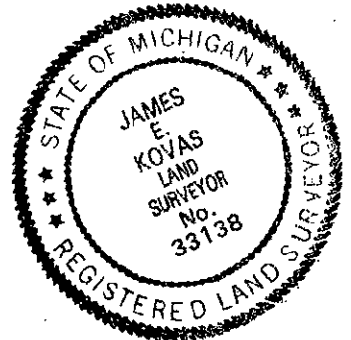

Signed by James Kovas Date 12/23/99

Surveyor's Michigan License No. 33138