

LAND CORNER RECORDATION CERTIFICATE  
Filing Requirement of Act 74, Mich. P.A. 1970

1923

For corners in

Oakland  
(county)

Located In: Corner Code #

1. Public Land Survey

Holly Township  
T 5N R 7E C-12  
T \_\_\_ R \_\_\_ SURVEY &  
T \_\_\_ R \_\_\_ RECONSTRUCTION

2. Property Controlling in Section

S \_\_\_ T \_\_\_ R \_\_\_  
S \_\_\_ T \_\_\_ R \_\_\_ MAR 21 2000

3. Miscellaneous Property in Sec.

S \_\_\_ T \_\_\_ R \_\_\_  
S \_\_\_ T \_\_\_ R \_\_\_ SECTION

LIBER 20945 PAGE 518  
\$7.00 MISC RECORDING  
\$2.00 REMONUMENTATION  
01/04/2000 07:37:46 A.M. RECEIPT# 342  
PAID RECORDED - OAKLAND COUNTY  
G. WILLIAM CADDELL, CLERK/REGISTER OF DEEDS

Conforms with  
ACT 74, P.A. 1970

REMOVED ON 10-28-98 JS  
OAKLAND COUNTY REMONUMENTATION  
FIELD GROUP COLLECTORS  
Register of Deeds Stamp & File Number

4. Lot No. \_\_\_\_\_, Recorded Plat \_\_\_\_\_

5. Private Claims \_\_\_\_\_

I, James E. Kovas, in a field survey on August 18, 1998, do hereby certify that under requirements of P.A. 74, Michigan P.A. of 1970, the corner points mentioned in lines 1 and 2 above were in conformance with regulations and rules therefore as required in the current manual of survey instructions of the United States Department of the Interior, Bureau of Land Management or by a decree of a Court of Law and/or that the corner points mentioned in lines 3, 4 and 5 above were in conformance with the rules of the Michigan Board of Land Surveyors or by a Decree of a Court of Law; established, re-established, monumented, re-monumented, recovered, found as expressed below:

	A	B	C	D	E	F	G	H	I	J	K	L	I
2	6		5		4		3		2		1		
3													
4	7		8		9		10		11		12		
5													
6	16		17		18		15		14		13		
7													
8	19		20		21		22		23		24		
9													
10	30		29		28		27		26		25		
11													
12	31		32		33		34		35		36		
13													

NOTE: Not more than 4 corners, all in the same town and range, may be recorded on this certificate.

A. Description of original monument and accessories and/or subsequent restoration:

- C-12
- 1816 - G.L.O., Alex Holmes, D.S., set post
- 1977 - John Albright #10057 (LCRC Liber 7077, Page 264) monument
- 1996 - Jack Owens #20709 (Survey Liber 16926, Page 624) found rod (cap #10057) 1.5' South of railroad tie anchor post

- Distances:
- C-12 to C-11 = 2666.70' (Wade-Trim, 1998)
  - C-12 to C-11 = 2666.89' (Owens, 1996)
  - C-12 to C-11 = 2666.85' (Ward, 1979)
  - C-12 to C-13 = 2639.51' (Wade-Trim, 1998)

B. Description of corner evidence found and/or method applied in restoring or reestablishing corner:

C-12 Found 1/2" iron.


WITNESSES FOUND:

- East 12.70' to 30" Oak found 12.73'
- South 25.90' to 30" Oak found 25.90'
- N 45 W 19.90' to Twin 6" Oak found 20.56'
- N 82 E 12.72' to found spike in 30" Oak found 12.73'
- S 10 E 25.80' to found spike in 30" Oak found 25.90'
- S 35 E 20.55' to found spike in 10" Oak found 20.56'
- N 88 W 13.01' to found spike in 10" Oak found 13.00'

C. Description of monument for corner and accessories established to perpetuate locating the position of the corner:

C-12 Found 1/2" iron. Set concrete monument with remon cap #33138.

- WIT:
- West 13.12' Set tag in 12" Oak
  - S 20 E 26.29' Set tag in 30" Oak
  - S 35 E 20.63' Set tag in 8" Oak
  - N 70 E 12.65' Set tag in 30' Oak

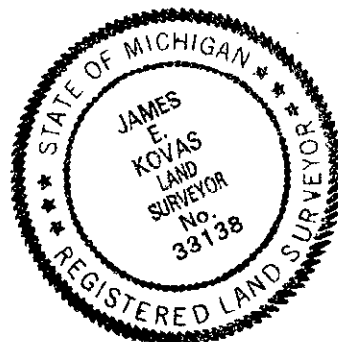

Signed by

*James E. Kovas*

Date

12/23/99

Surveyor's Michigan License No. 33138