

LAND CORNER RECORDATION CERTIFICATE
Filing Requirement of Act 74, Mich. P.A. 1970

LIBER 20945 PAGE 521
\$7.00 MISC RECORDING
\$2.00 REMONUMENTATION
01/04/2000 07:37:46 A.M. RECEIPT# 342
PAID RECORDED - OAKLAND COUNTY
G. WILLIAM CABELL, CLERK/REGISTER OF DEEDS

For corners in

Oakland Located In: Corner Code #
(county)

1. Public Land Survey T 5N R 7E D-3
T R
T R SURVEY &
T R RE-MONUMENTATION
2. Property Controlling S T R
in Section S T R MAR 21 2000
3. Miscellaneous S T R
Property in Sec. S T R
SECTION

Compliance with
ACT 343, P.A. 1999

APPROVED ON: 9-13-99 JS
OAKLAND COUNTY SURVEYOR
Register of Deeds Stamp & File Number

4. Lot No. _____, Recorded Plat _____

5. Private Claims _____

I, James E. Kovas, in a field survey on March 30, 1999, do hereby certify that under requirements of P.A. 74, Michigan P.A. of 1970, the corner points mentioned in lines 1 and 2 above were in conformance with regulations and rules therefore as required in the current manual of survey instructions of the United States Department of the Interior, Bureau of Land Management or by a decree of a Court of Law and/or that the corner points mentioned in lines 3, 4 and 5 above were in conformance with the rules of the Michigan Board of Land Surveyors or by a Decree of a Court of Law; established, re-established, monumented, re-monumented, recovered, found as expressed below:

	A	B	C	D	E	F	G	H	I	J	K	L	N
2	6	5	4	3	2	1							
3													
4	7	8	9	10	11	12							
5													
6	18	17	16	15	14	13							
7													
8	19	20	21	22	23	24							
9													
10	30	29	28	27	26	25							
11													
12	31	32	33	34	35	36							
13													

NOTE: Not more than 4 corners, all in the same town and range, may be recorded on this certificate.

A. Description of original monument and accessories and/or subsequent restoration:

D-3
1816 - G.L.O., Alex Holmes, D.S., set post
1989 - Gil Bonno #32332 (LCRC Liber 11603, Page 676 and Survey Liber 11603, Page 679) found bent "T" iron
1993 - David Erickson #29245 (LCRC Liber 13830, Page 141 and Liber 14171, Page 231) found "T" iron

Distances: D-3 to E-3 = 2651.52' (Wade-Trim, 1999)
D-3 to E-3 = 2651.54' (Sheridan, 1993)
D-3 to C-3 = 2651.44' (Wade-Trim, 1999)


B. Description of corner evidence found and/or method applied in restoring or reestablishing corner:

D-3 Found "T" iron.
N 70 W 46.15' to 16" Ash found 46.10'
N 49 W 46.15' to nail and tag #32332 SW of 18" Ash found 46.10'
S 47 E 21.98' to nail and tag in NE of 5" Elm found 21.97'
S 7 W 22.11' to nail and tag in East of Tripple 8" Ash found 22.16'

C. Description of monument for corner and accessories established to perpetuate locating the position of the corner:

D-3 Found "T" iron 5' +/- South centerline Belford Road. Removed and replaced 5/8" iron with Cap #33138.

WIT: N 20 E 32.31' Set P.K. nail w/Tag #33138 in 6" Maple Twin
S 50 E 21.97' Set P.K. nail w/Tag #33138 in 6" Elm
South 22.14' Set P.K. nail w/Tag #33138 in 8" Triple Ash
N 55 W 46.20' Set P.K. nail w/Tag #33138 in 18" Ash

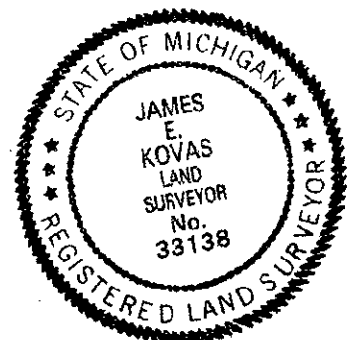

Signed by James E. Kovas Date 12/22/99

Surveyor's Michigan License No. 33138