

LAND CORNER RECORDATION CERTIFICATE  
Filing Requirement of Act 74, Mich. P.A. 1970

COVER 20945 PAGE 523  
\$2.00 MISC RECORDING  
\$2.00 REMONUMENTATION  
01/04/2000 07:37:46 A.M. RECEIPT# 342  
PAID RECORDED - OAKLAND COUNTY  
G. WILLIAM CADDELL, CLERK/REGISTER OF DEEDS

For corners in

Oakland Located In: Corner Code #  
(county)  
Holly Township  
1. Public Land Survey T 5N R 7E D-7  
T \_\_\_ R \_\_\_ SURVEY &  
T \_\_\_ R \_\_\_ REMONUMENTATION  
2. Property Controlling S \_\_\_ T \_\_\_ R \_\_\_  
in Section S \_\_\_ T \_\_\_ R \_\_\_ MAR 21 2000  
3. Miscellaneous S \_\_\_ T \_\_\_ R \_\_\_  
Property in Sec. S \_\_\_ T \_\_\_ R \_\_\_  
SECTION

Compliance with  
ACT 74, P.A. 1999  
APPROVED ON: 9-8-99 JH  
OAKLAND COUNTY REMONUMENTATION  
TECH GROUP COMMITTEE  
Register of Deeds Stamp & File Number

4. Lot No. \_\_\_\_\_, Recorded Plat \_\_\_\_\_  
5. Private Claims \_\_\_\_\_

I, James E. Kovas, in a field survey on November 19, 1999, do hereby certify that under requirements of P.A. 74, Michigan P.A. of 1970, the corner points mentioned in lines 1 and 2 above were in conformance with regulations and rules therefore as required in the current manual of survey instructions of the United States Department of the Interior, Bureau of Land Management or by a decree of a Court of Law and/or that the corner points mentioned in lines 3, 4 and 5 above were in conformance with the rules of the Michigan Board of Land Surveyors or by a Decree of a Court of Law; established, re-established, monumented, re-monumented, recovered, found as expressed below:

	A	B	C	D	E	F	G	H	I	J	K	L
2		6		5		4		3		2		1
3												
4		7		8		9		10		11		12
5												
6		18		17		16		15		14		13
7												
8		19		20		21		22		23		24
9												
10		30		29		28		27		26		25
11												
12		31		32		33		34		35		36
13												


NOTE: Not more than 4 corners, all in the same town and range, may be recorded on this certificate.

A. Description of original monument and accessories and/or subsequent restoration:  
D-7  
1816 - G.L.O., Alex Holmes, D.S., set post  
1974 - Ed Anderson #11495 (LCRC Liber 6303, Page 736) found 1/2" iron at intersection of fences  
1981 - Chris Newman #24607 (unrecorded survey) found 1/2" rerod

Distances: D-7 to C-7 = 2633.70' (Wade-Trim, 1999)  
D-7 to E-7 = 2642.30' (Wade-Trim, 1999)  
D-7 to E-7 = 2642.30' (Newman, 1981)  
D-7 to D-8 center = 2614.63' (Wade-Trim, 1999)  
D-7 to D-8 center = 2614.63' (Newman, 1981)

B. Description of corner evidence found and/or method applied in restoring or reestablishing corner:  
D-7 Found 1/2" iron.  
This corner is in a swamp and all trees have fallen down.

C. Description of monument for corner and accessories established to perpetuate locating the position of the corner:  
D-7 Found 1/2" iron pipe in swamp. Removed and replaced with concrete monument cap #33138.  
WIT: N 12 W 46.59' Set P.K. nail w/Tag #33138 in 8" Birch  
S 75 W 20.88' Set P.K. nail w/Tag #33138 in 6" Elm  
S 30 W 39.78' Set P.K. nail w/Tag #33138 in 12" Elm Twin

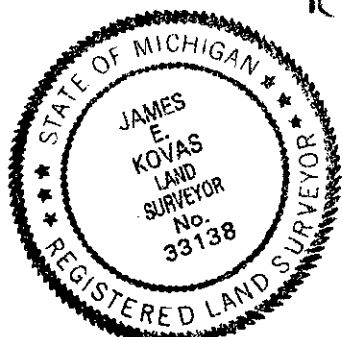

Signed by James E. Kovas Date 12/23/99