

LAND CORNER RECORDATION CERTIFICATE
Filing Requirement of Act 74, Mich. P.A. 1970

LIBER 20945 PAGE 527
\$7.00 MISC RECORDING
\$2.00 REMONUMENTATION
01/04/2000 07:37:45 A.M. RECEIPT# 342
PAID RECORDED - OAKLAND COUNTY
G. WILLIAM CADDELL, CLERK/REGISTER OF DEEDS

For corners in

Oakland (county) Located In: Corner Code #
Holly Township
1. Public Land Survey T 5N R 7E E-1
T R
T R
T R SURVEY & RE-ESTABLISHMENT
2. Property Controlling S T R
in Section S T R
3. Miscellaneous S T R
Property in Sec. S T R MAR 21 2000

REGISTER OF DEEDS
ACTS & P.A. (1922)
9-8-99 JIL
Register of Deeds Stamp & File Number

4. Lot No. _____, Recorded Plat _____ SECTION _____
5. Private Claims _____

I, James E. Kovas, in a field survey on July 30, 1998, do hereby certify that under requirements of P.A. 74, Michigan P.A. of 1970, the corner points mentioned in lines 1 and 2 above were in conformance with regulations and rules therefore as required in the current manual of survey instructions of the United States Department of the Interior, Bureau of Land Management or by a decree of a Court of Law and/or that the corner points mentioned in lines 3, 4 and 5 above were in conformance with the rules of the Michigan Board of Land Surveyors or by a Decree of a Court of Law; established, re-established, monumented, re-monumented, recovered, found as expressed below:

	A	B	C	D	E	F	G	H	I	J	K	L	M
2	6		5		4		3		2		1		
3													
4	7		8		9		10		11		12		
5													
6	18		17		16		15		14		13		
7													
8	19		20		21		22		23		24		
9													
10	30		29		28		27		26		25		
11													
12	31		32		33		34		35		36		
13													

NOTE: Not more than 4 corners, all in the same town and range, may be recorded on this certificate.

A. Description of original monument and accessories and/or subsequent restoration:
E-1
1816 - G.L.O., Alex Holmes, D.S., set post
1950 - Oakland County Road Commission (corner witnesses) no monument described

Distances:
E-1 to E-2 = 2959.50' (Wade-Trim, 1998)
E-1 to E-2 = 2960.76' (84.86 chains GLO)
E-1 to E-2 = 2959.36' (Misjak, 1991)
E-1 to E-2 = 2960.67' (Phillips, 1979)

E-1 to D-1 = 2698.86' (Wade-Trim, 1999)
E-1 to F-1 = 2621.34' (Wade-Trim, 1999)

E-1 to E-13 (Grand Blanc) = 22.47' west (Wade-Trim, 1999)
E-1 to E-13 (Grand Blanc) = 21.12' west (32 links GLO)

B. Description of corner evidence found and/or method applied in restoring or reestablishing corner:
E-1 Found 1/2" rerod.


WITNESSES FOUND:

W 22' to pipe for SE corner Section 32, Genesee found 22.47'
West 22.5' to pipe for SE corner Section 32, Genesee Co. found 22.47'
SW 27.02' to tree found 27.07'
South 33.20' to center of Consumers Power R/W marker found 33.27'
S 45 W 27.05' to Bonno tag in 18" Oak found 27.07'
N 5 W 19.63' to CHMP tag in twin 10" Oak found 19.60'

C. Description of monument for corner and accessories established to perpetuate locating the position of the corner:

E-1 Found 1/2" iron bent at top. Reset 5/8" iron and remon cap #33138.

WIT: N 17 W 22.19' Set P.K./tag #33138 NE face 24" Oak
N 53 W 50.40' Set P.K./tag #33138 South face 8" Hickory
S 60 W 27.56' Set P.K./tag #33138 North face 24" Oak
N 73 E 149.19' Set P.K./tag #33138 South face power poll
West 22.47' Found 3/4" pipe

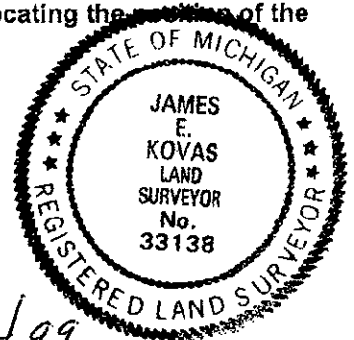

Signed by James E. Kovas Date 12/22/99