

LAND CORNER RECORDATION CERTIFICATE
Filing Requirement of Act 74, Mich. P.A. 1970

1933

For corners in

Oakland Located In: Corner Code #
(county)
1. Public Land Survey T 5N R 7E E-2
T R
T R
T R
2. Property Controlling S T R
in Section S T R
3. Miscellaneous S T R
Property in Sec. S T R

LIBER 20945 PAGE 528
\$7.00 MISC RECORDING
\$2.00 REMONUMENTATION
01/04/2000 07:37:46 A.M. RECEIPT# 342
PAID RECORDED - OAKLAND COUNTY
G. WILLIAM CADDELL, CLERK/REGISTER OF DEEDS

APPROVED BY
ACT 74, P.A. 1970
4-15-99 53
REGISTER OF DEEDS STAMP & FILE NUMBER

SECTION

4. Lot No. _____, Recorded Plat _____

5. Private Claims _____

I, James E. Kovas, in a field survey on September 8, 1998, do hereby certify that under requirements of P.A. 74, Michigan P.A. of 1970, the corner points mentioned in lines 1 and 2 above were in conformance with regulations and rules therefore as required in the current manual of survey instructions of the United States Department of the Interior, Bureau of Land Management or by a decree of a Court of Law and/or that the corner points mentioned in lines 3, 4 and 5 above were in conformance with the rules of the Michigan Board of Land Surveyors or by a Decree of a Court of Law; established, re-established, monumented, re-monumented, recovered, found as expressed below:

A	B	C	D	E	F	G	H	I	J	K	L
2	6	5	4	3	2	1					
3											
4	7	8	9	10	11	12					
5											
6	13	17	16	15	14	13					
7											
8	19	20	21	22	23	24					
9											
10	30	29	28	27	26	25					
11											
12	31	32	33	34	35	36					
13											

NOTE: Not more than 4 corners, all in the same town and range, may be recorded on this certificate.

A. Description of original monument and accessories and/or subsequent restoration:

E-2
1816 - G.L.O., Alex Holmes, D.S., set post

Distances: E-2 to E-3 = 2631.02' (Wade-Trim, 1999)
E-2 to E-1 = 2959.50' (Wade-Trim, 1999)
E-2 to E-1 = 2959.36' (Misjak, 1991)
E-2 to E-1 = 2960.67' (Phillips, 1979)
E-2 to E-1 = 2960.76' (84.86 chains, GLO)

B. Description of corner evidence found and/or method applied in restoring or reestablishing corner:

E-2 Found 1/2" rerod over "T" iron which is next to a pinch top pipe.


WITNESSES FOUND:

W 33.08' to Consumers Power Company R/W marker found 33.08'

C. Description of monument for corner and accessories established to perpetuate locating the position of the corner:

E-2 Found 1/2" iron, surface .3 down "t" iron; old fence post .6' down pinch iron pipe. Removed & replaced with concrete monument Cap #33138.

WIT: N 15 W 45.89' SW leg Detroit Edison tower
N 10 E 46.11' SE leg Detroit Edison tower
N 40 E 74.46' Nail in power pole West wood Detroit Edison pole West side
West 33.10' Detroit Edison marker

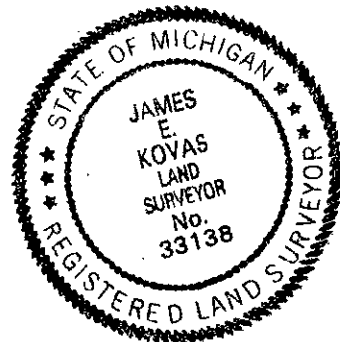

Signed by James E. Kovas

Date 12/23/99

Surveyor's Michigan License No. 33138