

LAND CORNER RECORDATION CERTIFICATE
Filing Requirement of Act 74, Mich. P.A. 1970

LIBER 20945 PAGE 529
\$7.00 MISC RECORDING
\$2.00 REMONUMENTATION
01/04/2000 07:37:46 A.M. RECEIPT# 342
PAID RECORDED - OAKLAND COUNTY
G. WILLIAM CADDELL, CLERK/REGISTER OF DEEDS

For corners in

Oakland Located In: Corner Code #
(county)
1. Public Land Survey Holly Township
T 5N R 7E E-3
T R
T R SURVEY &
T R RE-ESTABLISHMENT
2. Property Controlling S T R
in Section S T R
3. Miscellaneous S T R
Property in Sec. S T R MAR 21 2000

REGISTERED LAND SURVEYOR
AGNES M. DODD
APPROVED AND FILED
OAKLAND COUNTY REGISTER OF DEEDS
RECORDED
Register of Deeds Stamp & File Number

SECTION

4. Lot No. _____, Recorded Plat _____

5. Private Claims _____

I, James E. Kovas, in a field survey on July 27, 1998, do hereby certify that under requirements of P.A. 74, Michigan P.A. of 1970, the corner points mentioned in lines 1 and 2 above were in conformance with regulations and rules therefore as required in the current manual of survey instructions of the United States Department of the Interior, Bureau of Land Management or by a decree of a Court of Law and/or that the corner points mentioned in lines 3, 4 and 5 above were in conformance with the rules of the Michigan Board of Land Surveyors or by a Decree of a Court of Law; established, re-established, monumented, re-monumented, recovered, found as expressed below:

NOTE: Not more than 4 corners, all in the same town and range, may be recorded on this certificate.

A. Description of original monument and accessories and/or subsequent restoration:

- E-3
1816 - G.L.O., Alex Holmes, D.S., set post
1977 - John Albright #10057 (LCRC Liber 7077, Page 264)
1993 - David Erickson #29245 (LCRC Liber 13820, Page 141 and Liber 14171, Page 231) found 1-1/4" iron pipe

- Distances:
- E-3 to D-3 = 2651.52' (Wade-Trim, 1999)
 - E-3 to D-3 = 2651.54' (Sheridan, 1993)
 - E-3 to F-3 = 2604.83' (Wade-Trim, 1999)
 - E-3 to F-3 = 2605.04' (Newman, 1992)
 - E-3 to E-2 = 2631.02' (Wade-Trim, 1999)
 - E-3 to E-4 = 2630.37' (Wade-Trim, 1999)

B. Description of corner evidence found and/or method applied in restoring or reestablishing corner:

E-3 Found 1-1/4" pipe.


WITNESSES FOUND:

- S 60 W 67.58' to 30" Oak found 67.45'
- N 60 W 62.15' to telephone pole found 62.69'
- N 55 E 62.92' to P.K. and tag #11192 in South of 16" Oak found 62.86'
- S 71 W 67.36' to nail and tag in centerline of 36" Oak stump found 67.45'
- N 68 W 62.72' to SE corner of electric riser box found 62.69'

C. Description of monument for corner and accessories established to perpetuate locating the position of the corner:

E-3 Found 1-1/4" pipe. Reset 1/2" iron cap #33138.

- WIT:
- N 05 E 35.71' Set P.K./tag #33138 West face 14" Oak
 - N 55 E 62.91' Set P.K./tag #33138 SW face 18" Oak
 - S 05 W 120.53' Set P.K./tag #33138 North face 26" Oak
 - S 10 E 198.30' Set P.K./tag #33138 North face 18" twin Basswood

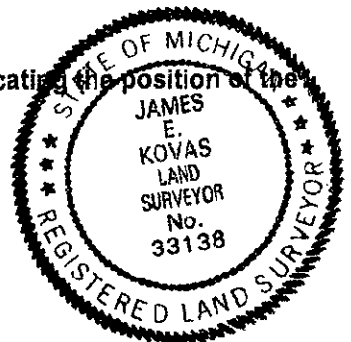

Signed by James E. Kovas

Date 12/22/99

Surveyor's Michigan License No. 33138

