

LAND CORNER RECORDATION CERTIFICATE  
Filing Requirement of Act 74, Mich. P.A. 1970

1935

LIBER 20945 PAGE 530  
\$7.00 MISC RECORDING  
\$2.00 REMONUMENTATION  
01/04/2000 07:37:46 A.M. RECEIPT# 342  
PAID RECORDED - OAKLAND COUNTY  
G. WILLIAM CADDELL, CLERK/REGISTER OF DEEDS

For corners in

Oakland Located In: Corner Code #  
(county)

- 1. Public Land Survey T 5N R 7E E-4
- 2. Property Controlling S T R REF SURVEY & in Section S T R RE-ESTABLISHMENT
- 3. Miscellaneous S T R MAR 21 2000 Property in Sec. S T R

9-15-99 53  
Register of Deeds Stamp & File Number

- 4. Lot No. \_\_\_\_\_, Recorded Plat \_\_\_\_\_ SECTION
- 5. Private Claims \_\_\_\_\_

I, James E. Kovas, in a field survey on March 29, 1999, do hereby certify that under requirements of P.A. 74, Michigan P.A. of 1970, the corner points mentioned in lines 1 and 2 above were in conformance with regulations and rules therefore as required in the current manual of survey instructions of the United States Department of the Interior, Bureau of Land Management or by a decree of a Court of Law and/or that the corner points mentioned in lines 3, 4 and 5 above were in conformance with the rules of the Michigan Board of Land Surveyors or by a Decree of a Court of Law; established, re-established, monumented, re-monumented, recovered, found as expressed below:

| A  | B  | C  | D  | E  | F  | G  | H | I | J | K | L |
|----|----|----|----|----|----|----|---|---|---|---|---|
| 2  | 6  | 5  | 4  | 3  | 2  | 1  |   |   |   |   |   |
| 3  |    |    |    |    |    |    |   |   |   |   |   |
| 4  | 7  | 8  | 9  | 10 | 11 | 12 |   |   |   |   |   |
| 5  |    |    |    |    |    |    |   |   |   |   |   |
| 6  | 13 | 17 | 16 | 15 | 14 | 13 |   |   |   |   |   |
| 7  |    |    |    |    |    |    |   |   |   |   |   |
| 8  | 19 | 20 | 21 | 22 | 23 | 24 |   |   |   |   |   |
| 9  |    |    |    |    |    |    |   |   |   |   |   |
| 10 | 30 | 29 | 28 | 27 | 26 | 25 |   |   |   |   |   |
| 11 |    |    |    |    |    |    |   |   |   |   |   |
| 12 | 31 | 32 | 33 | 34 | 35 | 36 |   |   |   |   |   |
| 13 |    |    |    |    |    |    |   |   |   |   |   |

NOTE: Not more than 4 corners, all in the same town and range, may be recorded on this certificate.

A. Description of original monument and accessories and/or subsequent restoration:

E-4  
1816 - G.L.O., Alex Holmes, D.S., set post

- Distances: E-4 to E-3 = 2630.37' (Wade-Trim, 1999)
- E-4 to E-3 = 2630.50' (Tax map)
- E-4 to E-5 = 2630.27' (Wade-Trim, 1999)

B. Description of corner evidence found and/or method applied in restoring or reestablishing corner:

E-4 Found 1/2" rerod.


WITNESSES FOUND:

This iron was obviously put on line at split the distance. We could not find a record of who split the section.

C. Description of monument for corner and accessories established to perpetuate locating the position of the corner:

E-4 Found 1/2" iron at centerline of Mitchell Road 5'+/- West centerline Fish Lake. Placed cap #33138.

- WIT: N 43 E 95.95' Set P.K. nail w/tag #33138 power pole
- S 45 E 37.50' Set P.K./nail w/tag #33138 power pole
- S 26 W 50.08' Set P.K./nail w/tag #33138 14" Oak
- N 50 W 22.64' Set P.K./nail w/tag #33138 12" Maple
- N 5 E 84.55' Set P.K./nail w/tag #33138 30" Oak

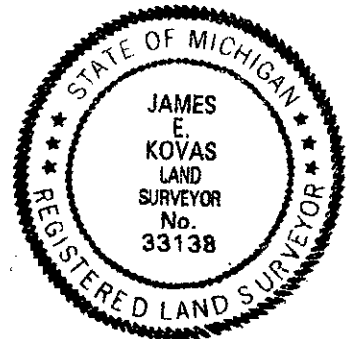

Signed by James E. Kovas Date 12/22/99

Surveyor's Michigan License No. 33138