

LAND CORNER RECORDATION CERTIFICATE  
Filing Requirement of Act 74, Mich. P.A. 1970

1936

For corners in

LIBER 20945 PAGE 531  
\$7.00 MISC RECORDING  
\$2.00 REMONUMENTATION  
01/04/2000 07:37:46 A.M. RECEIPT# 342  
PAID RECORDED - OAKLAND COUNTY  
G. WILLIAM CADDELL, CLERK/REGISTER OF DEEDS

<u>Oakland</u> (county)	Located In:	Corner Code #
1. Public Land Survey	Holly Township T. 5N R. 7E E-5	
2. Property Controlling in Section	T. R. SURVEY & RE-MONUMENTATION	
3. Miscellaneous Property in Sec.	T. R. MAR 21 2000	

APPROVED BY: 8-4-95 JIL  
OAKLAND COUNTY REMONUMENTATION  
7-881 GROUP COMMERCIAL  
Register of Deeds Stamp & File Number

SECTION

4. Lot No. \_\_\_\_\_, Recorded Plat \_\_\_\_\_

5. Private Claims \_\_\_\_\_

I, James E. Kovas, in a field survey on March 30, 1999, do hereby certify that under requirements of P.A. 74, Michigan P.A. of 1970, the corner points mentioned in lines 1 and 2 above were in conformance with regulations and rules therefore as required in the current manual of survey instructions of the United States Department of the Interior, Bureau of Land Management or by a decree of a Court of Law and/or that the corner points mentioned in lines 3, 4 and 5 above were in conformance with the rules of the Michigan Board of Land Surveyors or by a Decree of a Court of Law; established, re-established, monumented, re-monumented, recovered, found as expressed below:

**NOTE: Not more than 4 corners, all in the same town and range, may be recorded on this certificate.**

**A. Description of original monument and accessories and/or subsequent restoration:**

E-5  
1816 - G.L.O., Alex Holmes, D.S., set post

- Distances:
- E-5 to E-4 = 2630.27' (Wade-Trim, 1999)
  - E-5 to E-4 = 2624.16 (39.76 chains Baldwin survey 1890?)
  - E-5 to D-5 = 2624.37' (Wade-Trim, 1999)
  - E-5 to F-5 = 2643.40' (Wade-Trim, 1999)
  - E-5 to E-6 = 2650.44' (Wade-Trim, 1999)

**B. Description of corner evidence found and/or method applied in restoring or reestablishing corner:**

E-5 Found "T" iron.


WITNESSES FOUND:

- |        |        |             |       |        |
|--------|--------|-------------|-------|--------|
| N 40 W | 40.60' | 12" Hickory | found | 40.60' |
| N 65 E | 42.65' | 12" Maple   | found | 42.60' |
| S 85 E | 31.50' | 6" Hickory  | found | 31.50' |
| S 50 W | 44.95' | 10" Pine    | Gone  |        |

**C. Description of monument for corner and accessories established to perpetuate locating the position of the corner:**

E-5 Found "T" iron at centerline of Fish Lake Road. Centerline Kurtz Road. Removed and replaced 5/8" iron with cap #33138.

- WIT:
- N 20 E 100.40' Set P.K. nail w/tag #33138 14" Oak
  - S 78 E 31.54' Set P.K. nail w/tag #33138 8" Hickory
  - S 30 W 60.36' Set P.K. nail w/tag #33138 12" Spruce
  - N 30 W 40.55' Set P.K./nail w/tag #33138 12" Hickory

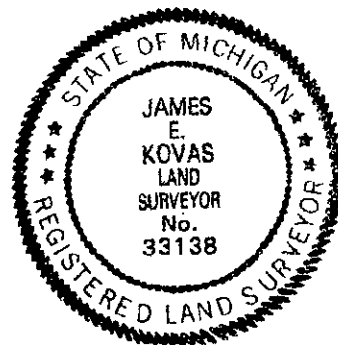

Signed by James E. Kovas Date 12/22/99

Surveyor's Michigan License No. 33138