

LAND CORNER RECORDATION CERTIFICATE  
Filing Requirement of Act 74, Mich. P.A. 1970

LIBER 20945 PAGE 532  
\$7.00 MISC RECORDING  
\$2.00 REMONUMENTATION  
01/04/2000 07:37:46 A.M. RECEIPT# 342  
PAID RECORDED - OAKLAND COUNTY  
B. WILLIAM CADDELL, CLERK/REGISTER OF

For corners in

<u>Oakland</u> (county)	Located In:	Corner Code #
	Holly Township	
1. Public Land Survey	T 5N R 7E	E-6
	T R	
	T R	
	T R	
2. Property Controlling in Section	S T R	<del>REMONUMENTATION</del>
	S T R	
3. Miscellaneous Property in Sec.	S T R	MAR 21 2000
	S T R	

RECORDED  
ACT 74, P.A. 1970  
11-3-99 JK  
OAKLAND COUNTY REMONUMENTATION  
COMMITTEE  
Register of Deeds Stamp & File Number

SECTION

4. Lot No. \_\_\_\_\_, Recorded Plat \_\_\_\_\_

5. Private Claims \_\_\_\_\_

I, James E. Kovas, in a field survey on December 18, 1999, do hereby certify that under requirements of P.A. 74, Michigan P.A. of 1970, the corner points mentioned in lines 1 and 2 above were in conformance with regulations and rules therefore as required in the current manual of survey instructions of the United States Department of the Interior, Bureau of Land Management or by a decree of a Court of Law and/or that the corner points mentioned in lines 3, 4 and 5 above were in conformance with the rules of the Michigan Board of Land Surveyors or by a Decree of a Court of Law; established, re-established, monumented, re-monumented, recovered, found as expressed below:

	A	B	C	D	E	F	G	H	I	J	K	L
2	6	5	4	3	2	1						
3												
4	7	8	9	10	11	12						
5												
6	18	17	16	15	14	13						
7												
8	19	20	21	22	23	24						
9												
10	30	29	28	27	26	25						
11												
12	31	32	33	34	35	36						
13												

NOTE: Not more than 4 corners, all in the same town and range, may be recorded on this certificate.

A. Description of original monument and accessories and/or subsequent restoration:

E-6  
1816 - G.L.O., Alex Holmes, D.S., set post

Distances: E-6 to E-5 = 2651.69' (Wade-Trim, 1999)

E-6 to E-7 = 2644.99 (Wade-Trim, 1999)

B. Description of corner evidence found and/or method applied in restoring or reestablishing corner:

E-6 No monument found.


No surveys or LCRC's of record. But Chris Newman told Wade-Trim that he set his corner in a survey located to the northwest. A bent iron was found next to a fence post on the west side of the road. Newman's iron in the road was not located. Newman has not been able to find the survey he did to establish this corner yet.

No tax map distances for this corner. We recommend that this corner be set according to records from Chris Newman's survey.

C. Description of monument for corner and accessories established to perpetuate locating the position of the corner:

E-6 Found 1/2" iron and iron pipe. Removed and replaced with concrete monument cap #33138.

WIT: 31.39' Set P.K. nail w/tag #33138 14" Oak  
23.32' Set P.K. nail w/tag #33138 16" Oak  
11.42' Set P.K. nail w/tag #33138 Guard Post  
9.93' Guard Post

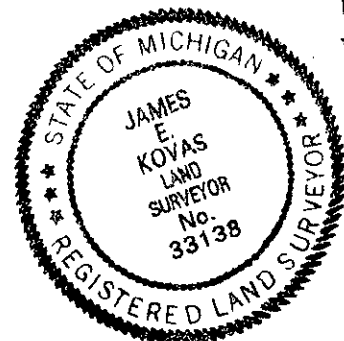

Signed by James E. Kovas Date 12/23/99

Surveyor's Michigan License No. 33138