

LAND CORNER RECORDATION CERTIFICATE
Filing Requirement of Act 74, Mich. P.A. 1970

1938

LIBER 20945 PAGE 533
\$7.00 MISC RECORDING
\$2.00 REMONUMENTATION
01/04/2000 07:37:46 A.M. RECEIPT# 342
PAID RECORDED - OAKLAND COUNTY
G. WILLIAM CADDELL, CLERK/REGISTER OF DEEDS

For corners in

Oakland Located In: Corner Code #
(county)
1. Public Land Survey T 5N R 7E E-7
T ___ R ___
T ___ R ___
T ___ R ___
2. Property Controlling S ___ T ___ R ___
in Section S ___ T ___ R ___
3. Miscellaneous S ___ T ___ R ___
Property in Sec. S ___ T ___ R ___

Compliance with
ACT 365, P.A. 1990

APPROVED ON: 9-23-98 JS
LAND COUNTY REMONUMENTATION
PER GROUP COMMITTEE

Register of Deeds Stamp & File Number

SECTION

4. Lot No. _____, Recorded Plat _____
5. Private Claims _____

I, James E. Kovas, in a field survey on February 24, 1999, do hereby certify that under requirements of P.A. 74, Michigan P.A. of 1970, the corner points mentioned in lines 1 and 2 above were in conformance with regulations and rules therefore as required in the current manual of survey instructions of the United States Department of the Interior, Bureau of Land Management or by a decree of a Court of Law and/or that the corner points mentioned in lines 3, 4 and 5 above were in conformance with the rules of the Michigan Board of Land Surveyors or by a Decree of a Court of Law; established, re-established, monumented, re-monumented, recovered, found as expressed below:

	A	B	C	D	E	F	G	H	I	J	K	L
2		6		5		4		3		2		
3												
4		7		8		9		10		11		
5												
6		18		17		16		15		14		
7												
8		19		20		21		22		23		
9												
10		30		29		28		27		26		
11												
12		31		32		33		34		35		
13												

NOTE: Not more than 4 corners, all in the same town and range, may be recorded on this certificate.

A. Description of original monument and accessories and/or subsequent restoration:

E-7
1816 - G.L.O., Alex Holmes, D.S., set post
1962 - Oakland County Road Commission, found iron pipe


Distances: E-7 to F-7 = 2650.82' (Wade-Trim, 1999)
E-7 to F-7 = 2651.03' (Newman - 1992)
E-7 to E-6 = 2644.99' (Wade-Trim, 1999)
E-7 to E-8 = 2646.46' (Wade-Trim, 1998)
E-7 to E-8 = 2646.40' (Newman, 1992)
E-7 to E-8 = 2646.62' (Newman, 1988)
E-7 to D-7 = 2642.30' (Wade-Trim, 1999)
E-7 to D-7 = 2642.30' (Newman, 1981)

B. Description of corner evidence found and/or method applied in restoring or reestablishing corner:

E-7 Found 1/2" iron in monument box.
S 55 W 120.78' to NE corner of garage found 120.75'
N 75 E 123.75' to twin 15" Walnut found 123' center
West 34.00' to tag in fence post found 34.20'

C. Description of monument for corner and accessories established to perpetuate locating the position of the corner:

E-7 Found 1/2" iron in monument box. Replaced cap #33138.
WIT: N 24 W 35.39' Set P.K. nail w/tag #33138 fence post
S 70 W 70.87' Set P.K. nail w/tag #33138 10" Apple
S 39 E 101.76' Set P.K. nail w/tag #33138 power pole
N 73 E 96.52' Set P.K. nail w/tag #33138 power pole

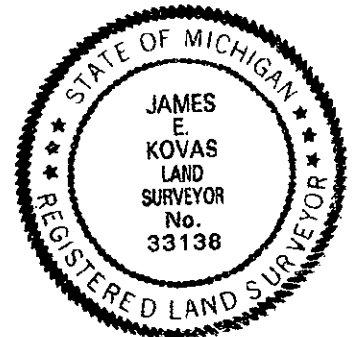

Signed by James E. Kovas Date 12/22/99