

LAND CORNER RECORDATION CERTIFICATE
Filing Requirement of Act 74, Mich. P.A. 1970

1939

LIBER 20945 PAGE 534
\$7.00 MISC RECORDING
\$2.00 REMONUMENTATION
01/04/2000 07:37:46 A.M. RECEIPT# 342
PAID RECORDED - OAKLAND COUNTY
G. WILLIAM CADDELL, CLERK/REGISTER OF DEEDS

For corners in

Oakland Located In: Corner Code #
(county)
1. Public Land Survey Holly Township
T 5N R 7E E-8
T ___ R ___
T ___ R ___
T ___ R ___
2. Property Controlling S ___ T ___ R ___
in Section S ___ T ___ R ___
3. Miscellaneous S ___ T ___ R ___
Property in Sec. S ___ T ___ R ___

SURVEY & REMONUMENTATION
MAR 21 2000
SECTION

REGISTERED LAND SURVEYOR
JAMES E. KOVAS
9-23-98 53
REGISTER OF DEEDS STAMP & FILE NUMBER

4. Lot No. _____, Recorded Plat _____
5. Private Claims _____

A	B	C	D	E	F	G	H	I	J	K
2	6	5	4	3	2					
3										
4	7	8	9	10	11					
5										
6	16	17	18	19	20	21	22	23		
7										
8	19	20	21	22	23					
9										
10	30	29	28	27	26					
11										
12	31	32	33	34	35					
13										

I, James E. Kovas, in a field survey on July 17, 1998, do hereby certify that under requirements of P.A. 74, Michigan P.A. of 1970, the corner points mentioned in lines 1 and 2 above were in conformance with regulations and rules therefore as required in the current manual of survey instructions of the United States Department of the Interior, Bureau of Land Management or by a decree of a Court of Law and/or that the corner points mentioned in lines 3, 4 and 5 above were in conformance with the rules of the Michigan Board of Land Surveyors or by a Decree of a Court of Law; established, re-established, monumented, re-monumented, recovered, found as expressed below:

NOTE: Not more than 4 corners, all in the same town and range, may be recorded on this certificate.

A. Description of original monument and accessories and/or subsequent restoration:

- E-8 1816 - G.L.O., Alex Holmes, D.S., set post
- 1952 - Oakland County Road Commission, set 1/2" bar
- 1973 - John Albright #10057 (LCRC Liber 6373, Page 884)

Distances: E-8 to E-7 = 2646.46' (Wade-Trim, 1998)
E-8 to E-7 = 2646.40' (Newman, 1992)
E-8 to E-7 = 2646.62' (Newman, 1988)
E-8 to E-9 = 2627.91' (Wade-Trim, 1998)
E-8 to E-9 = 2627.61' (Newman, 1991)

B. Description of corner evidence found and/or method applied in restoring or reestablishing corner:


E-8 Found 1/2" iron in monument box.

WITNESSES FOUND:

S 80 E 48.60' to Power pole found (Gould tag) 48.81'
N 50 W 79.27' to anchor post found (Gould tag) 80.78'

Found the following unrecorded witnesses:

S 45 W 64.43' to Gould tag on top of 6" wood post
East 49.90' to AT+/- iron

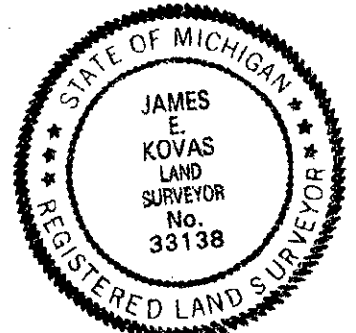

C. Description of monument for corner and accessories established to perpetuate locating the position of the corner:

E-8 Found 1/2" iron in monument box. Set remon cap on top of iron.

WIT: S 25 E 82.90' Set remon tag w/mag nail on top of first fence post north of driveway to house #14209 Fish Lake
S 70 E 48.83' Set remon tag w/mag nail in South face of power pole
N 20 E 129.51' Set remon tag w/mag nail in West face of power pole
S 55 W 83.95' Set remon tag w/mag nail in NW face of 10" Cottonwood

Signed by James E. Kovas

Date 12/22/99

Surveyor's Michigan License No. 33138