

LAND CORNER RECORDATION CERTIFICATE
Filing Requirement of Act 74, Mich. P.A. 1970

1942

For corners in

Oakland Located in: Holly Township Corner Code # E-11
(county)

1. Public Land Survey T 5N R 7E _____
T _____ R _____
T _____ R _____
T _____ R _____

2. Property Controlling S _____ T _____ R _____
in Section S _____ T _____ R _____

3. Miscellaneous S _____ T _____ R _____
Property in Sec. S _____ T _____ R _____

LIBER 20945 PAGE 537
\$7.00 MISC RECORDING
\$2.00 REMONUMENTATION
01/04/2000 07:37:46 A.M. RECEIPT# 34
PAID RECORDED - OAKLAND COUNTY
G. WILLIAM CADDELL, CLERK/REGISTER OF DEEDS

RECORDED
9-8-99 512

Register of Deeds Stamp & File Number

SECTION

4. Lot No. _____, Recorded Plat _____

5. Private Claims _____

A	B	C	D	E	F	G	H	I	J	K
2	6	5	4	3	2					
3										
4	7	8	9	10	11					
5										
6	13	17	16	15	14					
7										
8	19	20	21	22	23					
9										
10	30	29	28	27	26					
11										
12	31	32	33	34	35					
13										

I, James E. Kovas, in a field survey on October 27, 1998, do hereby certify that under requirements of P.A. 74, Michigan P.A. of 1970, the corner points mentioned in lines 1 and 2 above were in conformance with regulations and rules therefore as required in the current manual of survey instructions of the United States Department of the Interior, Bureau of Land Management or by a decree of a Court of Law and/or that the corner points mentioned in lines 3, 4 and 5 above were in conformance with the rules of the Michigan Board of Land Surveyors or by a Decree of a Court of Law; established, re-established, monumented, re-monumented, recovered, found as expressed below:

NOTE: Not more than 4 corners, all in the same town and range, may be recorded on this certificate.

A. Description of original monument and accessories and/or subsequent restoration:

- E-11 1816 - G.L.O., Alex Holmes, D.S., set post
- 1990 - Brad Thompson #23828 (Survey Liber 11913, Page 546 and LCRC Liber 11922, Page 505)
Set 1/2" iron w/bft cap in riverbed

- Distances:
- E-11 to E-10 = 2631.36' (Wade-Trim, 1999)
 - E-11 to E-10 = 2631.44' (Thompson, 1990)
 - E-11 to E-12 = 2651.19' (Wade-Trim, 1999)
 - E-11 to D-11 = 2640.14' (Wade-Trim, 1999)
 - E-11 to D-11 = 2640.00' (Thompson, 1990)
 - E-11 to F-11 = 2635.56' (Wade-Trim, 1999)

B. Description of corner evidence found and/or method applied in restoring or reestablishing corner:


E-11 The iron in the riverbed was gone, washed away.

We found the first three witnesses listed in Thompson's LCRC above and reset this corner. The check distance to a Thompson iron found at the SW corner of his Parcel 5 is: 794.05' (M) - 794.03' (R) from Thompson survey

C. Description of monument for corner and accessories established to perpetuate locating the position of the corner:

E-11 Old iron washed out on riverbed reestablished iron from old witnesses. Placed 2" iron rod 32" long along edge of bank.

- WIT:
- South 74.55' Set P.K. nail w/tag #33138 30" Oak North face
 - West 20.58' Set P.K. nail w/tag #33138 guardrail post North face
 - East 44.85' Set P.K. nail w/tag #33138 8" Willow North face
 - N 15 E 44.66' Set P.K. nail w/tag #33138 8" Willow East face

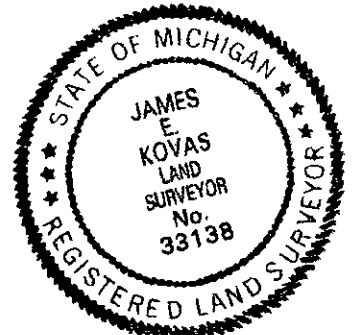

Signed by James E. Kovas

Date 12/22/99

Surveyor's Michigan License No. 33138