

LAND CORNER RECORDATION CERTIFICATE
Filing Requirement of Act 74, Mich. P.A. 1970

1944

For corners in

LIBER 20945 PAGE 539
\$7.00 MISC RECORDING
\$2.00 REMONUMENTATION
11/26/2000 07:37:46 A.M. RECEIVED 342
PAID REGISTERED - OAKLAND COUNTY
G. MILLION CORRELL, CLERK/REGISTER OF DEEDS

Oakland Located in: Corner Code #
(county)
1. Public Land Survey Holly Township
T 5N R 7E E-13
T ___ R ___
T ___ R ___
T ___ R ___
2. Property Controlling S ___ T ___ R ___
in Section S ___ T ___ R ___
3. Miscellaneous S ___ T ___ R ___
Property in Sec. S ___ T ___ R ___

10-28-99 JS
Register of Deeds Stamp & File Number

SECTION

4. Lot No. _____, Recorded Plat _____
5. Private Claims _____

I, James E. Kovas, in a field survey on September 8, 1998, do hereby certify that under requirements of P.A. 74, Michigan P.A. of 1970, the corner points mentioned in lines 1 and 2 above were in conformance with regulations and rules therefore as required in the current manual of survey instructions of the United States Department of the Interior, Bureau of Land Management or by a decree of a Court of Law and/or that the corner points mentioned in lines 3, 4 and 5 above were in conformance with the rules of the Michigan Board of Land Surveyors or by a Decree of a Court of Law; established, re-established, monumented, re-monumented, recovered, found as expressed below:

A	B	C	D	E	F	G	H	I	J	K	L
2	6	5	4	3	2	1					
3											
4	7	8	9	10	11	12					
5											
6	18	17	16	15	14	13					
7											
8	19	20	21	22	23	24					
9											
10	30	29	28	27	26	25					
11											
12	31	32	33	34	35	36					
13											

NOTE: Not more than 4 corners, all in the same town and range, may be recorded on this certificate.

A. Description of original monument and accessories and/or subsequent restoration:

- E-13 1816 - G.L.O., Alex Holmes, D.S., set post
- 1965 - County Road Commission (section ties) found 3/4" pipe
- 1995 - Grant Ward #22445 (Survey Liber 16095, Page 684) no monument described

- Distances:
- E-13 to F-13 = 2623.67' (Wade-Trim, 1999)
 - E-13 to D-13 = 2640.87' (Wade-Trim, 1998)
 - E-13 to D-13 = 2640.88' (Ward, 1995)
 - E-13 to E-12 = 2646.02' (Wade-Trim, 1998)
 - E-13 to E-12 = 2645.63' (Newman, 1991)
 - E-13 to E-1 (Rose) = 161.66' west (Wade-Trim, 1998)
 - E-13 to E-1 (Rose) = 161.80' west (Newman, 1986)

B. Description of corner evidence found and/or method applied in restoring or reestablishing corner:

E-13 Found 1" pipe near fence post.


WITNESSES FOUND:

- N 20 E 23.62' to 24" Beech found 24.00'
- N 84 W 161.80' to NE corner of Section 5, T4N, R7E (1/2" rod in box) found 161.66'
- N 20 E 23.62' to twin 24" Beech found 24.00'

C. Description of monument for corner and accessories established to perpetuate locating the position of the corner:

E-13 Found 1" pipe in fence post. Removed and replaced with concrete monument cap #33138.

- WIT:
- N 20 E 25.02' Set nail w/Tag #33138 18" Twin Ash
 - East 42.96' Set nail w/Tag #33138 12" Ash
 - N 80 W 21.96' Centerline fence post
 - S 20 E 27.45' Set nail w/Tag #33138 16" Cherry

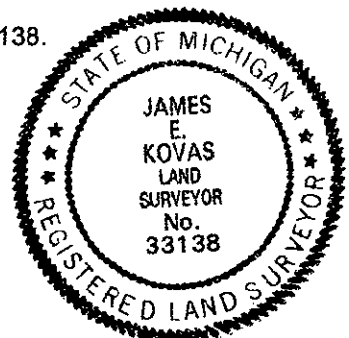

Signed by James E. Kovas Date 12/22/99