

LAND CORNER RECORDATION CERTIFICATE  
Filing Requirement of Act 74, Mich. P.A. 1970

1945

For corners in

Oakland Located In: Corner Code #  
(county)  
Holly Township  
1. Public Land Survey T 5N R 7E F-1  
T R  
T R  
T R  
2. Property Controlling S T R  
in Section S T R  
3. Miscellaneous S T R  
Property in Sec. S T R MAR 21 2000

LIBER 20945 PAGE 540  
\$7.00 MISC RECORDING  
\$2.00 REMONUMENTATION  
01/04/2000 07:37:46 A.M. RECEIPT# 342  
PAID RECORDED - OAKLAND COUNTY  
G. WILLIAM CADDELL, CLERK/REGISTER OF DEED

Register of Deeds Stamp & File Number

SECTION

4. Lot No. \_\_\_\_\_, Recorded Plat \_\_\_\_\_

5. Private Claims \_\_\_\_\_

I, James E. Kovas, in a field survey on November 2, 1999, do hereby certify that under requirements of P.A. 74, Michigan P.A. of 1970, the corner points mentioned in lines 1 and 2 above were in conformance with regulations and rules therefore as required in the current manual of survey instructions of the United States Department of the Interior, Bureau of Land Management or by a decree of a Court of Law and/or that the corner points mentioned in lines 3, 4 and 5 above were in conformance with the rules of the Michigan Board of Land Surveyors or by a Decree of a Court of Law; established, re-established, monumented, re-monumented, recovered, found as expressed below:

A	B	C	D	E	F	G	H	I	J	K
2	6	5	4	3	2					
3										
4	7	8	9	10	11					
5										
6	13	17	16	15	14					
7										
8	19	20	21	22	23					
9										
10	30	29	28	27	26					
11										
12	31	32	33	34	35					
13										

NOTE: Not more than 4 corners, all in the same town and range, may be recorded on this certificate.

A. Description of original monument and accessories and/or subsequent restoration:

F-1  
1816 - G.L.O., Alex Holmes, D.S., no post set

Distances: F-1 to E-1 = 2621.34' (Wade-Trim, 1999)  
F-1 to E-1 = 2621.15' (Misjak, 1991)

F-1 to G-1 = 2608.80' (Wade-Trim, 1999)  
F-1 to G-1 = 2609.07' (Newman, 1997)

F-1 to F-13 (Grand Blanc) = 7.47' east (Wade-Trim, 1999)  
F-1 to F-13 (Grand Blanc) = 6.26' east (Newman, 1997)

B. Description of corner evidence found and/or method applied in restoring or reestablishing corner:

F-1 Found "T" iron. Found iron at NW corner parcel B on Misjak survey; 1631.59' (M) 1630.58' (R)


WITNESSES FOUND:

East 6.26'	to found pipe South 1/4 corner, Section 33 Grand Blanc	found 7.47'
S 20 E 28.97'	to found tag in 10" Oak	found 28.95'
N 5 E 24.76'	to found tag in 18" Hickory	found 24.63'
South 47.00'	to found tag in 24" Oak	found 47.08'
East 13.73'	to found tag in twin 18" Hickory	found 13.71'

C. Description of monument for corner and accessories established to perpetuate locating the position of the corner:

F-1 Set concrete monument with brass remon cap #33138.

WIT: N 20 E 24.72' Set mag nail with PS #33138 remon tag in 20" White Oak  
S 83 E 13.68' Set mag nail with PS #33138 remon tag in 18" White Oak  
S 05 W 47.03' Set mag nail with PS #33138 remon tag in 30" Cherry  
Due West 40.97' Set mag nail with PS #33138 remon tag in 12" White Oak

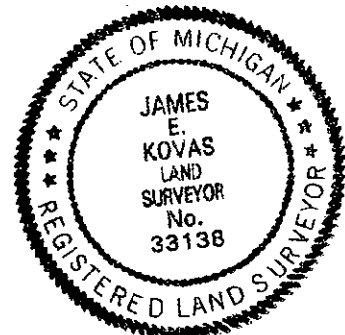

Signed by James E. Kovas Date 12/22/99

Surveyor's Michigan License No. 33138