

LAND CORNER RECORDATION CERTIFICATE
Filing Requirement of Act 74, Mich. P.A. 1970

LIBER 20945 PAGE 541
MISE RECORDING
\$2.00 REMONUMENTATION
01/04/2000 07:37:46 A.M. RECEIPT# 342
PAID RECORDED - OAKLAND COUNTY
G. WILLIAM CADDELL, CLERK/REGISTER OF DEEDS

For corners in

<u>Oakland</u> (county)	Located In:	Corner Code #
	Holly Township	
1. Public Land Survey	T <u>5N</u> R <u>7E</u>	<u>F-3</u>
	T ___ R ___	___
	T ___ R ___	___
	T ___ R ___	___
2. Property Controlling in Section	S ___ T ___ R ___	___
	S ___ T ___ R ___	___
3. Miscellaneous Property in Sec.	S ___ T ___ R ___	___
	S ___ T ___ R ___	___

SURVEY & REMONUMENTATION
MAR 21 2000

Register of Deeds Stamp & File Number

4-15-99 33

SECTION

4. Lot No. _____, Recorded Plat _____

5. Private Claims _____

I, James E. Kovas, in a field survey on March 29, 1999, do hereby certify that under requirements of P.A. 74, Michigan P.A. of 1970, the corner points mentioned in lines 1 and 2 above were in conformance with regulations and rules therefore as required in the current manual of survey instructions of the United States Department of the Interior, Bureau of Land Management or by a decree of a Court of Law and/or that the corner points mentioned in lines 3, 4 and 5 above were in conformance with the rules of the Michigan Board of Land Surveyors or by a Decree of a Court of Law, established, re-established, monumented, re-monumented, recovered, found as expressed below:

	A	B	C	D	E	F	G	H	I	J	K	L
2	6		5		4		3		2			
3												
4	7		8		9		10		11			
5												
6	10		17		16		15		14			
7												
8	19		20		21		22		23			
9												
10	30		29		28		27		26			
11												
12	31		32		33		34		35			
13												

NOTE: Not more than 4 corners, all in the same town and range, may be recorded on this certificate.

A. Description of original monument and accessories and/or subsequent restoration:

F-3
1816 - G.L.O., Alex Holmes, D.S., set post

Distances: F-3 to E-3 = 2604.83' (Wade-Trim, 1999)
F-3 to E-3 = 2605.04' (Newman, 1992)
F-3 to G-3 = 2616.10' (Wade-Trim, 1999)
F-3 to G-3 = 2617.22' (Newman, 1988)

B. Description of corner evidence found and/or method applied in restoring or reestablishing corner:


F-3 Found 1/2" rerod at fence intersection.

Good agreement with Newman distances to east and west. So, we recommend that this corner be accepted.

C. Description of monument for corner and accessories established to perpetuate locating the position of the corner:

F-3 Found 1/2" iron rod in fence line East and South in rock pile. Removed and replaced concrete monument.

WIT: North 5.15' Set P.K. nail w/tag #33138
East 14.86' Set P.K. nail w/tag #33138
South 18.79' Set P.K. nail w/tag #33138
West 9.20' Set P.K. nail w/tag #33138

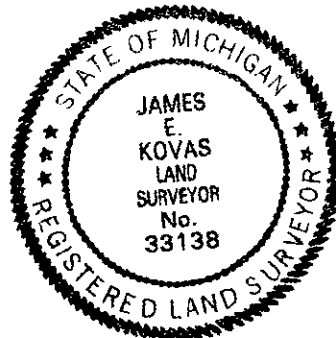

Signed by James E. Kovas

Date 12/22/99

Surveyor's Michigan License No. 33138