

LAND CORNER RECORDATION CERTIFICATE  
Filing Requirement of Act 74, Mich. P.A. 1970

1948

For corners in

Oakland Located In: Corner Code #  
(county)  
Holly Township  
1. Public Land Survey T 5N R 7E F-7  
T \_\_\_ R \_\_\_  
T \_\_\_ R \_\_\_  
T \_\_\_ R \_\_\_  
2. Property Controlling S \_\_\_ T \_\_\_ R \_\_\_  
in Section S \_\_\_ T \_\_\_ R \_\_\_  
3. Miscellaneous S \_\_\_ T \_\_\_ R \_\_\_  
Property in Sec. S \_\_\_ T \_\_\_ R \_\_\_


LIBER 20945 PAGE 543  
\$7.00 MISC RECORDING  
\$2.00 REMONUMENTATION  
01/04/2000 07:37:46 A.M. RECEIPT# 342  
PAID RECORDED - OAKLAND COUNTY  
G. WILLIAM CABDILL, CLERK/REGISTER OF DEEDS

3-31-99 53  
REGISTER OF DEEDS STAMP & FILE NUMBER

SECTION

4. Lot No. \_\_\_\_\_, Recorded Plat \_\_\_\_\_  
5. Private Claims \_\_\_\_\_

I, James E. Kovas, in a field survey on March 29, 1999, do hereby certify that under requirements of P.A. 74, Michigan P.A. of 1970, the corner points mentioned in lines 1 and 2 above were in conformance with regulations and rules therefore as required in the current manual of survey instructions of the United States Department of the Interior, Bureau of Land Management or by a decree of a Court of Law and/or that the corner points mentioned in lines 3, 4 and 5 above were in conformance with the rules of the Michigan Board of Land Surveyors or by a Decree of a Court of Law; established, re-established, monumented, re-monumented, recovered, found as expressed below:

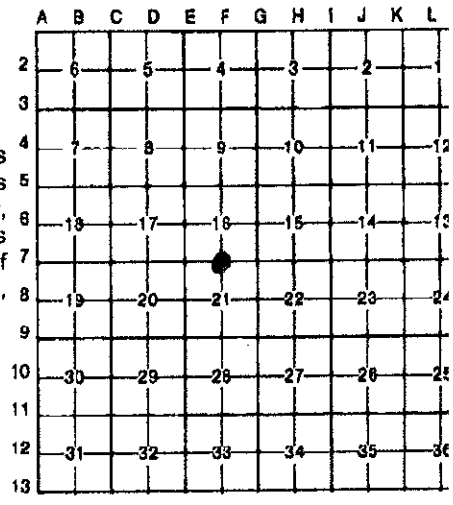

NOTE: Not more than 4 corners, all in the same town and range, may be recorded on this certificate.

A. Description of original monument and accessories and/or subsequent restoration:

- F-7
- 1816 - G.L.O., Alex Holmes, D.S., set post
- 1962 - Oakland County Road Commission, found stone
- 1972 - John Albright #10057 (LCRC Liber 6002, Page 508) found 5/8" rerod

Distances:  
F-7 to G-7 = 2649.95' (Wade-Trim, 1999)  
F-7 to E-7 = 2650.82' (Wade-Trim, 1999)  
F-7 to E-7 = 2651.03' (Newman, 1993)  
F-7 to F-5 = 5259.52' (Wade-Trim, 1999)  
F-7 to F-5 = 5259.16' (Newman, 1993)

B. Description of corner evidence found and/or method applied in restoring or reestablishing corner:

F-7 Found 5/8" iron.


WITNESSES FOUND:

SE 29.70' to 18" Hickory found 29.87'  
S 30 E 30.1' to 24" Hickory found 29.87'

C. Description of monument for corner and accessories established to perpetuate locating the position of the corner:

F-7 Found 5/8 iron in centerline road centerline North-South tree line removed and replaced with 5/8" iron 12" long cap #33138

WIT: N 44 W 43.09' Set P.K. nail w/tag #33138 24" Maple  
N 55 E 25.64' Set P.K. nail w/tag #33138 30" Hickory  
S 65 E 66.98' Set P.K. nail w/tag #33138 8" Quad Maple  
S 27 E 29.98' Set P.K. nail w/tag #33138 30" Hickory

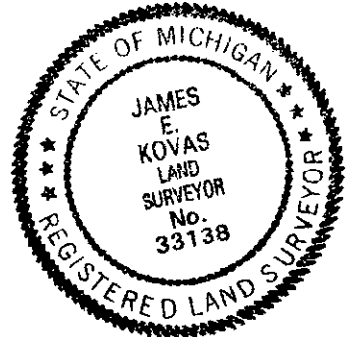

Signed by James E. Kovas Date 12/22/99

Surveyor's Michigan License No. 33138