

LAND CORNER RECORDATION CERTIFICATE
Filing Requirement of Act 74, Mich. P.A. 1970

1950

LIBER 20945 PAGE 545
\$7.00 MISC RECORDING
\$2.00 REMONUMENTATION
01/04/2000 07:37:46 A.M. RECEIPT# 342
PAID RECORDED - OAKLAND COUNTY
G. WILLIAM CADDELL, CLERK/REGISTER OF DEEDS

For corners in

Oakland Located In: Corner Code #
(county)

1. Public Land Survey T 5N R 7E F-11
T R
T R
T R
2. Property Controlling S T R SURVEY &
in Section S T R REMONUMENTATION
3. Miscellaneous S T R
Property in Sec. S T R MAR 21 2000

10-28-98 JS

Register of Deeds Stamp & File Number

4. Lot No. _____, Recorded Plat SECTION

5. Private Claims _____

I, James E. Kovas, in a field survey on September 9, 1998, do hereby certify that under requirements of P.A. 74, Michigan P.A. of 1970, the corner points mentioned in lines 1 and 2 above were in conformance with regulations and rules therefore as required in the current manual of survey instructions of the United States Department of the Interior, Bureau of Land Management or by a decree of a Court of Law and/or that the corner points mentioned in lines 3, 4 and 5 above were in conformance with the rules of the Michigan Board of Land Surveyors or by a Decree of a Court of Law; established, re-established, monumented, re-monumented, recovered, found as expressed below:

NOTE: Not more than 4 corners, all in the same town and range, may be recorded on this certificate.

A. Description of original monument and accessories and/or subsequent restoration:

- F-11
1816 - G.L.O., Alex Holmes, D.S., set post
1955 - Lakeside Homesites (Liber 76, Page 9) no monument described
1957 - Crescent Park Sub (Liber _____, Page _____) no monument described
1958 - Lakeside Homesites No. 2 (Liber 97, Page 3) no monument described
1979 - John Albright #10057 (LCRC Liber 7455, Page 861) found concrete monument

Distances: F-11 to G-11 = 2660.27' (Wade-Trim, 1998)
F-11 to E-11 = 2635.56' (Wade-Trim, 1999)

B. Description of corner evidence found and/or method applied in restoring or reestablishing corner:

F-11 Found concrete monument in fenceline. All of Albright's witnesses are gone.


The monument checks good with Irons in Lakeside Homesites and Crescent Park Subdivision irons.

C. Description of monument for corner and accessories established to perpetuate locating the position of the corner:

F-11 Found concrete monument. Placed cap #33138.

WIT: N 15 W 10.65' Set nail w/tag #33138 8" Ash
N 25 W 7.97' Set nail w/tag #33138 10" Box Elder
S 2 W 29.74' Set nail w/tag #33138 18" Ash

	A	B	C	D	E	F	G	H	I	J	K	L
2	8		5		4		3		2			
3												
4	7		6		9		10		11			
5												
6	18		17		16		15		14			
7												
8	19		20		21		22		23			
9												
10	30		29		28		27		26			
11												
12	31		32		33		34		35			
13												

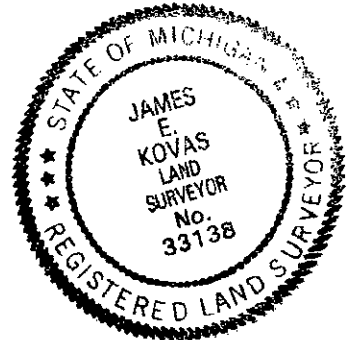

Signed by James E. Kovas Date 12/22/99

Surveyor's Michigan License No. 33138